

WARREN

L14

3-9-71

MISSISSIPPI BOARD OF WATER COMMISSIONERS  
416 North State Street  
Jackson, Mississippi 39201

ELOG#97

**CODED**

WATER WELL DRILLERS LOG

3/9

date well completed

19

71

Jack Quinn  
Water Well Ser.

firm name

Warren

county well located

LANDOWNER

Miss.

Highway Dept.

(mailing address)

WELL LOCATION:

sec. 19 T. 14 N. R. 5 E  
8 miles E of Neshville

WELL PURPOSE: Industrial  
(home, irrigation, municipal, industrial)

WELL COMPLETION DATA:

- (1) diameter (inches) 4 in.
- (2) total depth (feet) 220
- (3) static water level (feet) 104 below top of ground.
- (4) casing (material) Galv. (depth) 200

4 in. (size) if telescope see back.

- (5) screen 10 ft. 210 (length) (depth to top)  
2 in. Johnson SS (size) (material)

- (6) pump 3/4 (HP) 10 gal. (yield gpm)  
R. E. A. (type power)

- (7) electric log yes (yes or no)  
Miss. Geo. Survey (organization running log)

- (8) how well bottom plugged back  
not sure

description of formations encountered

from to

Brown dirt	0	26
Clay	26	36
Gravel	36	80
Rock	80	108
Blue mud	108	126
Sandy gray sand	126	220

**CODED**

JUN 13 1971

MISS. BD. OF WATER COMM.


DRILLERS REMARKS:

If well telescopes please sketch and show depths.

GROUND LEVEL

Water level 104 ft.  
210 ft. 4 in galv.  
4 X 2 sledge  
10 ft Johnson  
screen 75 8

If more than one screen,  
show locations of each on sketch.

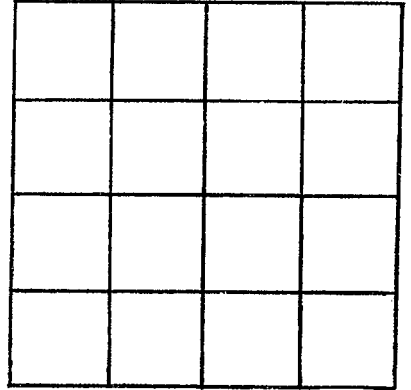

SECTION \_\_\_\_\_

Please indicate well location X.

ADDITIONAL INFORMATION

Lined area for additional information.