

WARREN

L 15

10-20-61

WATER WELL DRILLERS LOG

**CODED**

Date: 10-20 19 61

Driller:

*Robert*  
(Name)

County

*W. J. ...*  
*... ..*

(1) Owner of Land: *M. J. Jarrow*  
(Name)

*Beonia*  
(Address)

(2) Location:  $\frac{1}{4}$ ,  $\frac{1}{4}$ , Sec.  $\frac{12}{8}$  T16 R5

3 miles *N*, of *Beonia*  
(distance) (direction) (Nearest Town)

(3) Topography: *flat*  
(Hilly) (Flat) (Level)

(4) Purpose of Well: *Domestic*  
(Domestic, Irrigation, Municipal, Industrial, Other)

Description & Color of Materials  
Sand, Clay, Red Clay, Shell, etc.

Thick-  
ness  
Feet

Depth  
Feet

*0-57 clay*  
*57-59 white sand*

Information upon completion of well:

(1) Diameter 2 inches.

(2) Total Depth 59 feet.

(3) Water Level 32 feet below top of ground.

(4) Cased to 59, Size 2

(5) Screen: Size 106, Length 5'

(6) Were any formations sealed against pollution?


yes,  no

If YES depth of formation \_\_\_\_\_

Why \_\_\_\_\_

Drillers Remarks: \_\_\_\_\_

**CODED**

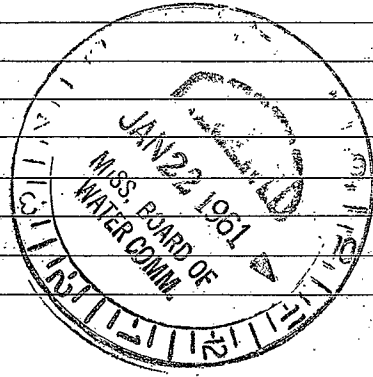

(Use Back Side)

Well No.

[The page contains extremely faint and illegible text, likely bleed-through from the reverse side of the document. The text is scattered across the page and cannot be transcribed accurately.]