

WARREN WATER WELL DRILLERS LOG

CODED

Date: 2-6-62, 19 62 Driller: [Signature] County Warren

2-6-62

- (1) Owner of Land: Miss E. J. Clutt
(Name)
- Winkley Miss
(Address)
- (2) Location: 1/4, 1/4, Sec. 12 T. 16R 4,
5 miles N.E., of Candler
(distance) (direction) (Nearest Town)
- (3) Topography: Hilly
(Hilly) (Flat) (Level)
- (4) Purpose of Well: Domestic
(Domestic Irrigation Municipal, Industrial, Other)

Description & Color of Materials Sand, Clay, Red Clay, Shell, etc.	Thick- ness Feet	Depth Feet
<u>0-45 clump</u>		
<u>45-110 white sand</u>		
<u>and gravel</u>		

Information upon completion of well:


- (1) Diameter 2 inches.
- (2) Total Depth 110 feet.
- (3) Water Level 54 feet below top of ground.
- (4) Cased to 110, Size 2.
- (5) Screen: Size 2, Length 5.
- (6) Were any formations sealed against pollution?
no.

CODED

If YES depth of formation _____

Why _____

Drillers Remarks: _____

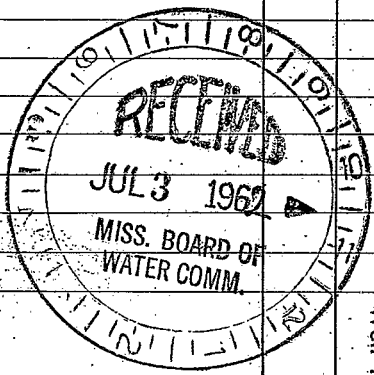

(Use Back Side)

Well No.

