

QL 17
5-3-62

WATER WELL DRILLERS LOG

CODED

Date: 5-3, 1962 Driller: [Signature] County: Warren

(Name)

(1) Owner of Land:	Description & Color of Materials Sand, Clay, Red Clay, Shell, etc.	Thick- ness Feet	Depth Feet
(Name) <u>Michael Neal</u> (Address) <u>Wicksburg Miss.</u>	<u>0-87 - mixed clay</u> <u>87-153 - sand gravel</u>		
(2) Location: <u>1/4</u> , <u>1/4</u> , Sec. <u>29 T16R5</u> <u>2</u> miles <u>west</u> of <u>Brownie</u> (distance) (direction) (Nearest Town)			
(3) Topography: <u>hilly</u> (Hilly) (Flat) (Level)			
(4) Purpose of Well: <u>Home</u> (Domestic Irrigation Municipal, Industrial, Other)			

Information upon completion of well.


- (1) Diameter 2 inches.
- (2) Total Depth 153 feet.
- (3) Water Level 100 feet below top of ground.
- (4) Cased to 153, Size 2
- (5) Screen: Size 2, Length 5'
- (6) Were any formations sealed against pollution?
 yes, no.

If YES depth of formation _____

Why _____

Drillers Remarks: _____

CODED

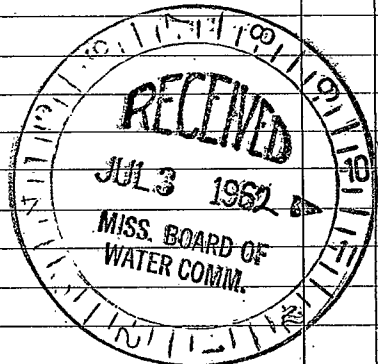

(Use Back Side)

Well No.

