

WARREN

4218

2-10-72

MISSISSIPPI BOARD OF WATER COMMISSIONERS
416 North State Street
Jackson, Mississippi 39201

CODED

WATER WELL DRILLERS LOG

2/10

date well completed

Jack E. Quinn

firm name

Warren

county well located

LANDOWNER:

James Williams

(mailing address)

description of formations encountered

from

to

Top soil	0	20
yellow sand	20	35
Rock	35	70
sand	70	80
sand	80	104

WELL LOCATION:

sec. 5 T 60 N R 40 E
S W
3 miles SE of Edwards
(distance) (direction) (nearest town)

WELL PURPOSE: Home
(home, irrigation, municipal, industrial)

WELL COMPLETION DATA:

- (1) diameter (inches) 4 in.
- (2) total depth (feet) 104
- (3) static water level (feet) 48 below above top of ground.
- (4) casing back 70
(material) (depth)
- 4 in. if telescope see back.
(size)
- (5) screen 10 70
(length) (depth to top)
- 2 in. 55
(size) (material)
- (6) pump 3/4 10
(HP) (yield gpm)
- R.E.G.
(type power)
- (7) electric log yes
(yes or no)
- M.S.L.
(organization running log)

CODED


(8) how well bottom plugged
Back was valve

DRILLERS REMARKS:

MAY 11 1972

If well telescopes please sketch and show depths.

GROUND LEVEL

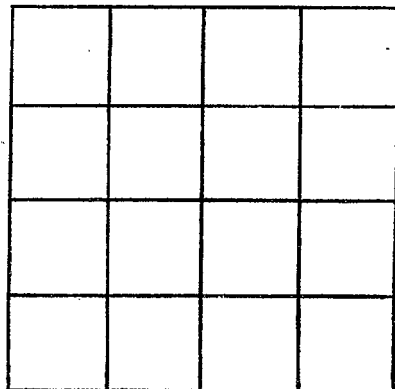

SECTION _____

Please indicate well location X.

ADDITIONAL INFORMATION

If more than one screen,
show locations of each on sketch.