

MISSISSIPPI BOARD OF WATER COMMISSIONERS
416 North State Street
Jackson, Mississippi 39201

CODED

WATER WELL DRILLERS LOG

WARREN
L 20 19
3-14-72

3/14 1972 date well completed
Jack C. Gunn firm name
Warren county well located

LANDOWNER

Willie Sims

description of formations encountered

from

to

Top soil	0	20
Sandy soil	20	40
Clay	40	60
Sandy shell	60	85
sand	85	120
Rock	120	165
sand	165	180
Chopped sand	180	210

(mailing address)

WELL LOCATION:

sec. 2 T 6 N R 5 E
8 miles ~~W~~ SE of Edwards
(distance) (direction) (nearest town)

WELL PURPOSE: Home
(home, irrigation, municipal, industrial)

WELL COMPLETION DATA:

- (1) diameter (inches) 2 in.
- (2) total depth (feet) 210
- (3) static water level (feet) 80 below above top of ground.
- (4) casing Galv. 165 (material) (depth)
2 in. (size) if telescope see back.
- (5) screen 10 165 (length) (depth to top)
2 in. (size) (material)
- (6) pump 1 3 1/2 (HP) (yield gpm)
P.E. a. (type power)
- (7) electric log yes (yes or no)
W.S. L.L. (organization running log)

CODED

2
W.S. L.L.
T-16N

(8) how well bottom plugged Back
wash valve


MAY 11 1972

DRILLERS REMARKS:

SECS. BY OF
WATER COMMISSIONERS

If well telescopes please sketch and show depths.

GROUND LEVEL

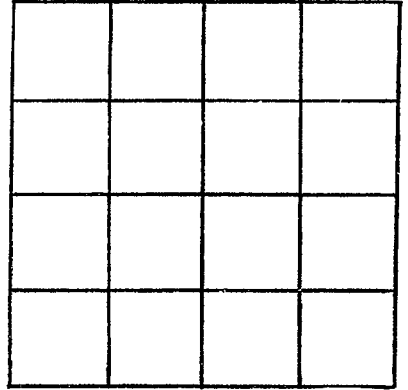

SECTION _____

Please indicate well location X.

ADDITIONAL INFORMATION

If more than one screen,
show locations of each on sketch.