

WARREN  
L22  
5-7-74  
FL #126  
5-7-1974

MISSISSIPPI  
BOARD OF WATER COMMISSIONERS  
416 North State Street  
Jackson, Mississippi 39201

WATER WELL DRILLERS LOG

CODED

JACK GUMM WARREN  
firm name county well located

date well completed

firm name

county well located

LANDOWNER:  
GRAY FLOWERS  
(mailing address)


description of formations encountered	from	to
TOP SOIL	0	1
CLAY	1	40
SAND & GRAVEL	40	77
CLAY	77	84
DRY CR	84	126
SAND	126	140

WELL LOCATION:  
sec. 13 T 16 N R 5 E  
(distance) miles (direction) of (nearest town)

WELL PURPOSE:  
(home, irrigation, municipal, industrial)

CODED

- WELL COMPLETION DATA:
- diameter (inches) 4"
  - total depth (feet) 126
  - static water level (feet) 53 below top of ground.
  - casing THC 126" (material) (depth)  
44" (size) if telescope see back.
  - screen 10' 126" (length) (depth to top)  
2" (size) 55 (material)
  - pump 1/2 (HP) 10 (yield gpm)  
MPL (type power)
  - electric log yes (yes or no)  
M.C.S. (organization running log)
  - how well bottom plugged 1300 U

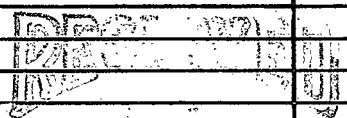


JUL 5 1974

DRILLERS REMARKS:

MISS. BD. OF WATER COMM

If well telescopes please sketch and show depths.

GROUND LEVEL

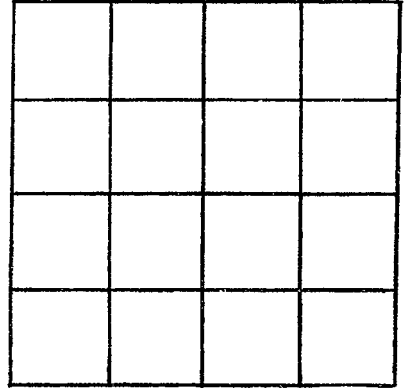

SECTION \_\_\_\_\_

Please indicate well location X.

ADDITIONAL INFORMATION

If more than one screen,  
show locations of each on sketch.