

**WARREN**  
**L23**  
**9-30-74**

MISSISSIPPI  
 BOARD OF WATER COMMISSIONERS  
 416 North State Street  
 Jackson, Mississippi 39201

**CODED**

**WATER WELL DRILLERS LOG**

09-30 1974 JACK Guinn WARREN  
 date well completed firm name county well located

| LANDOWNER:   | description of formations encountered | from      | to        |
|--|---------------------------------------|-----------|-----------|
| <u>LYLA Bird song</u>  | <u>Sand &amp; gravel</u>              | <u>1</u>  | <u>42</u> |
| (mailing address)  | <u>CLAY</u>                           | <u>42</u> | <u>52</u> |
| WELL LOCATION:   | <u>CLAY</u>                           | <u>52</u> | <u>60</u> |
| sec. <u>1</u> T. <u>16</u> N. R. <u>5</u> E                        | <u>Sand</u>                           | <u>60</u> | <u>72</u> |
| (distance) miles (direction) of (nearest town)                     |                                       |           |           |
| WELL PURPOSE:<br>(home, irrigation, municipal, industrial)         |                                       |           |           |
| WELL COMPLETION DATA:  |                                       |           |           |
| (1) diameter (inches) <u>4"</u>                                    |                                       |           |           |
| (2) total depth (feet) <u>92</u>                                   |                                       |           |           |
| (3) static water level (feet) <u>77</u> below/above top of ground. |                                       |           |           |
| (4) casing <u>T&amp;C</u> (material) <u>42</u> (depth)             |                                       |           |           |
| <u>4"</u> (size) if telescope see back.                            |                                       |           |           |
| (5) screen <u>10'</u> (length) <u>8.2</u> (depth to top)           |                                       |           |           |
| <u>4"</u> (size) <u>SS</u> (material)                              |                                       |           |           |
| (6) pump <u>3/4</u> (HP) <u>10</u> (yield gpm)                     |                                       |           |           |
| <u>MPL</u> (type power)  |                                       |           |           |
| (7) electric log <u>yes</u> (yes or no)                            |                                       |           |           |
| <u>USGS</u> (organization running log)                             |                                       |           |           |
| (8) how well bottom plugged <u>BWU</u>                             |                                       |           |           |
| DRILLERS REMARKS:  |                                       |           |           |

**CODED**


**DEPARTMENT OF REVENUE**

SEP 16 1974

MISS. DE. OF WATER COMMISSIONERS

If well telescopes please sketch and show depths.

GROUND LEVEL

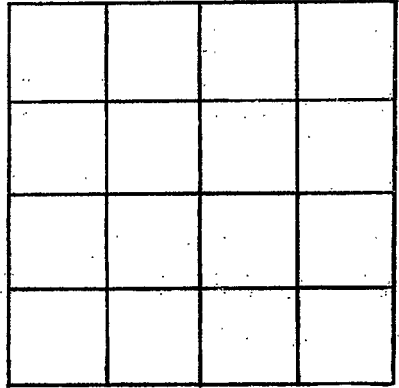

SECTION \_\_\_\_\_

Please indicate well location X.

ADDITIONAL INFORMATION

If more than one screen, show locations of each on sketch.