

L 24
 Warren
 5-2-75

MISSISSIPPI
 BOARD OF WATER COMMISSIONERS
 416 North State Street
 Jackson, Mississippi 39201

CODED

WATER WELL DRILLERS LOG

May 2 1975 E.M. "Bud" CRESSWELL Warren
 date well completed firm name county well located

LANDOWNER:
 Dr. J.A. Overby
 JACKSON, Mississippi
 (mailing address)

description of fomations encountered	from	to
Clay	0	35
Sand	35	47

WELL LOCATION:
 sec. 8 T. 6 N R. 4 W
 3 miles NE of Flowers
 (distance) (direction) (nearest town)

WELL PURPOSE: home
 (home, irrigation, municipal, industrial)

CODED

- WELL COMPLETION DATA:
- (1) diameter (inches) 2
 - (2) total depth (feet) 47
 - (3) static water level (feet) 35 below top of ground.
 - (4) casing Steel, 42,
 (material) (depth)
2 if telescope see back.
 (size)
 - (5) screen 5, 42
 (length) (depth to top)
2, STAINLESS
 (size) (material)
 - (6) pump 1, 5
 (HP) (yield gpm)
0
 (type power)
 - (7) electric log No
 (yes or no)
0
 (organization running log)
 - (8) how well bottom plugged
Steel Plug


RECEIVED
 MAY 2 1975

DRILLERS REMARKS:

MISS. RD. OF WA

If well telescopes please sketch and show depths.

GROUND LEVEL

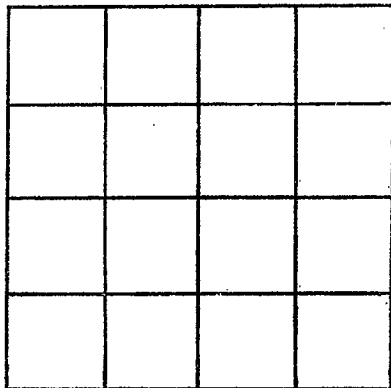

SECTION _____

Please indicate well location X.

ADDITIONAL INFORMATION

If more than one screen,
show locations of each on sketch.