

WARREN  
L 25  
4-14-19  
Log #150

12/79  
162 268  
12/21/79  
MISSISSIPPI  
BOARD OF WATER COMMISSIONERS  
416 North State Street  
Jackson, Mississippi 39201

CODED

WATER WELL DRILLERS LOG

4/14/79 1979 Jack C. Quinn Warren  
date well completed firm name county well located

LANDOWNER: Jerry Stewart  
Dickshur  
(mailing address)

description of formations encountered	from	to
top soil	0	10
Sand & gravel	10	70
Blue clay & shell	70	188
Rock	188	224
Sand & shell	224	260
Blue clay	260	403

WELL LOCATION:  
sec. 3 T. 16 N R. 5 E  
8 miles East of Dickshur  
(distance) (direction) (nearest town)

WELL PURPOSE: Test well  
(home, irrigation, municipal, industrial)

- WELL COMPLETION DATA:
- (1) diameter (inches) 9 in.
  - (2) total depth (feet) 403
  - (3) static water level (feet) 100 below top of ground.
  - (4) casing galvanized 220 ft.  
(material) (depth)  
6 in. if telescope see back.  
(size)
  - (5) screen 38 ft., 228 ft.  
(length) (depth to top)  
4 in. Stainless Steel  
(size) (material)
  - (6) pump 5 HP. 35  
(HP) (yield gpm)  
Electric  
(type power)
  - (7) electric log yes  
(yes or no)  
M.S.L.  
(organization running log)
  - (8) how well bottom plugged back  
was valve, sand seal

DRILLERS REMARKS:

CODED


Miss. Board of Water Comm.

APR 30 1979

REGISTERED

If well telescopes please sketch and show depths.

GROUND LEVEL

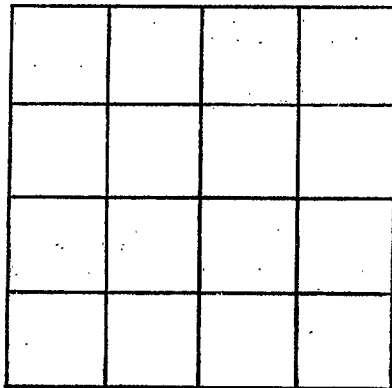

SECTION \_\_\_\_\_

Please indicate well location X.

ADDITIONAL INFORMATION

If more than one screen,  
show locations of each on sketch.