

MISSISSIPPI DEPARTMENT OF NATURAL RESOURCES

Bureau of Land and Water Resources

Southport Mall


P.O. Box 10637

Jackson, Mississippi 39209

WATER WELL DRILLERS LOG

Gruber Drilling Service, Inc.

Warren

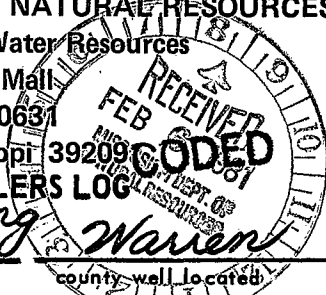

WARREN
L 29
1-23-81

date well completed

firm name

county well located

LANDOWNER:

Placid Oil Corp
P. O. Box 2416
Laurel, Ms 39440
(mailing address)

description of formations encountered

from

to

sand, clay, & rocks

0 168

WELL LOCATION:

25342528' W of NE
Unit 7 T 16 N R 5 E
7-2

clay, sand, some rock mostly clay

168 250

Barena of
(distance) miles (direction) of (nearest town)

clay, some breaks of sand

250 900

WELL PURPOSE: *oil field supply*
(home, irrigation, municipal, industrial)

sand, few breaks of clay

900 1134

WELL COMPLETION DATA:

(1) diameter (inches) *3"*

(2) total depth (feet) *1134'*

(3) static water level (feet) *150'* *below* above top of ground.

(4) casing *steel 1118'*
(material) (depth)

3" If telescope see back.
(size)

(5) screen *42'* *1076'*
(length) (depth to top)

3" *perforated*
(size) (material)

(6) pump *80*
(HP) (yield gpm)

ac
(type power)

(7) electric log *—*
(yes or no)


—
(organization running log)

(8) how well bottom plugged *orange peel*

DRILLERS REMARKS:

If well telescopes please sketch and show depths.

GROUND LEVEL

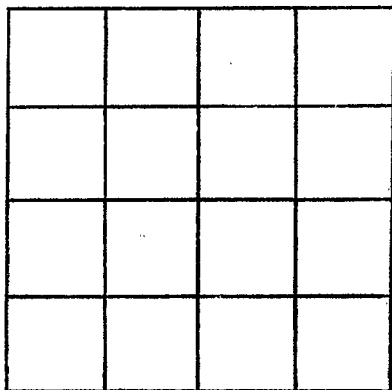

SECTION _____

Please indicate well location X.

ADDITIONAL INFORMATION

If more than one screen, show locations of each on sketch.