

MISSISSIPPI DEPARTMENT OF NATURAL RESOURCES

Bureau of Land and Water Resources

Southport Mall

P.O. Box 10631

Jackson, Mississippi 39209

CODED

WATER WELL DRILLERS LOG

WARREN
L 30
4-27-81

Griner Drilling Service, Inc.

Warren

4-27-81 date well completed

Griner Drilling Service, Inc. firm name

Warren county well located

LANDOWNER:

Placid Oil Corporation
P.O. Box E
Trout, Louisiana 71371
(mailing address)

description of formations encountered

from to

sand, clay, ↓ rocks 0 168

WELL LOCATION:

990' S + 1533' E

clay, sand, some rocks, mostly clay 168 250

No. 8 T. 166N R. 5E of NW/4
Unit 3 Bovina (distance) (direction) (nearest town)

clay, some breakers of sand 250 900

WELL PURPOSE:

oil field supply (home, irrigation, municipal, industrial)

sand, few breakers of clay 900 1232

WELL COMPLETION DATA:

(1) diameter (inches) 3"
(2) total depth (feet) 1232'
(3) static water level (feet) 150' below top of ground.

(4) casing Steel 1232' (material) (depth)
3" if telescope see back. (size)


(5) screen 42', 1190' (length) (depth to top)
3" perforated (size) (material)

(6) pump 80 (HP) (yield gpm)
Ac (type power)

(7) electric log (yes or no)
(organization running log)


(8) how well bottom plugged orange peel

DRILLERS REMARKS:

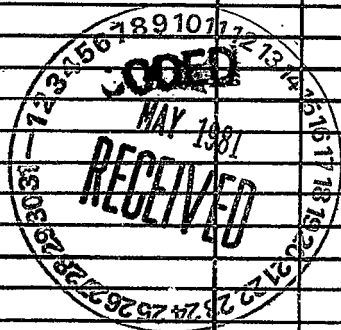

If well telescopes please sketch and show depths.

GROUND LEVEL

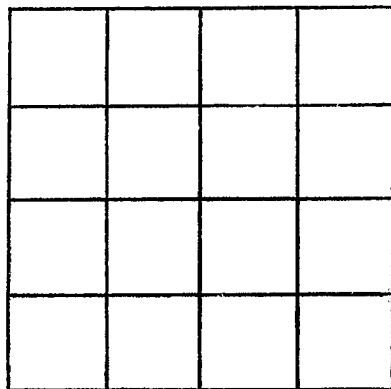

SECTION _____

Please indicate well location X.

ADDITIONAL INFORMATION

If more than one screen,
show locations of each on sketch.