

MISSISSIPPI DEPARTMENT OF NATURAL RESOURCES

Bureau of Land and Water Resources

Southport Mall

P.O. Box 10631

Jackson, Mississippi 39209

WATER WELL-DRILLERS LOG

CODED

WARREN  
L 31  
8-7-81

date well completed

firm name

county well located

8-7-81 *Griner Drilling Service, Inc.* Warren

LANDOWNER:  
*Placid Oil Corp.*  
*P.O. Box E*  
*Trout, La 71771*  
(mailing address)

description of formations encountered  
from to  
*clay, sand, rock 0 300*  
*clay, shell, 500 300 1033*  
*muddy clay* CODED

WELL LOCATION: *1500 N J 1588 W*  
*1/4 sec 6 T 160 N R 5 E of*  
*Unit Bonna Field*  
(distance) (direction) (nearest town)

WELL PURPOSE: *oil field supply*  
(home, irrigation, municipal, industrial)

WELL COMPLETION DATA:

- (1) diameter (inches) *3"*
- (2) total depth (feet) *1261'*
- (3) static water level (feet) *90'*  below  above top of ground.
- (4) casing *Steel, 1113'*  
(material) (depth)  
*3"*  
(size) if telescope see back.
- (5) screen *42', 1071'*  
(length) (depth to top)  
*3"*  
(size) *perforated*  
(material)
- (6) pump *80*  
(HP) (yield gpm)  
*AC*  
(type power)
- (7) electric log   
(yes or no)  
(organization running log)
- (8) how well bottom plugged *orange peel*

DEPT. OF NATURAL RESOURCES  
BUREAU OF LAND & WATER RESOURCES

AUG 26 1981


RECEIVED



DRILLERS REMARKS:

If well telescopes please sketch and show depths.

GROUND LEVEL

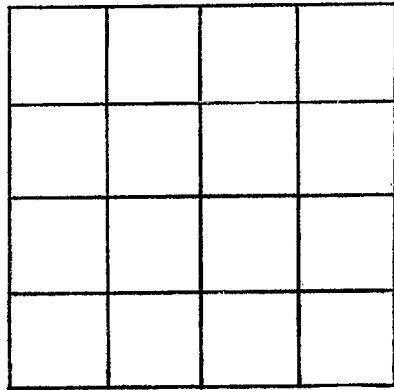

SECTION \_\_\_\_\_

Please indicate well location X.

ADDITIONAL INFORMATION

If more than one screen,  
show locations of each on sketch.