

MISSISSIPPI DEPARTMENT OF NATURAL RESOURCES

Bureau of Land and Water Resources

Southport Mall

P.O. Box 10631

Jackson, Mississippi 39209

WATER WELL DRILLERS LOG

Griner Drilling Service, Inc.

Warren

WARREN
L33
1/23/82

1-23-82 date well completed

Griner Drilling Service, Inc. firm name

Warren county well located

LANDOWNER:	description of formations encountered	from	to
Placid Oil P.O. Box E Trout, La 71731 (mailing address)	clay, rock	0	50
WELL LOCATION: 1753' N of 1500' E 5 T 16 N R 5 E SW COR	SAND, gravel	50	165
No. of units: 5 5 distance	clay, rock, shell	165	1120
Bovina (direction) of (nearest town)	SAND	1120	1211
WELL PURPOSE: Oil field supply (home, irrigation, municipal, industrial)			
WELL COMPLETION DATA:			
(1) diameter (inches) 3"			
(2) total depth (feet) 1211'			
(3) static water level (feet) 200' below top of ground.			
(4) casing steel, 1211' (material) (depth) 3" (size) if telescope see back.			
(5) screen 126', 1085' (length) (depth to top) 3", perforated (size) (material)			
(6) pump — 70 (HP) (yield gpm) A/C (type power)			
(7) electric log yes (yes or no) Bureau of Geology (organization running log)			
(8) how well bottom plugged orange peel			
DRILLERS REMARKS:			

CODED


DEPT. OF NATURAL RESOURCES
BUREAU OF LAND & WATER RESOURCES

FEB 16 1982

RECEIVED

If well telescopes please sketch and show depths.

GROUND LEVEL

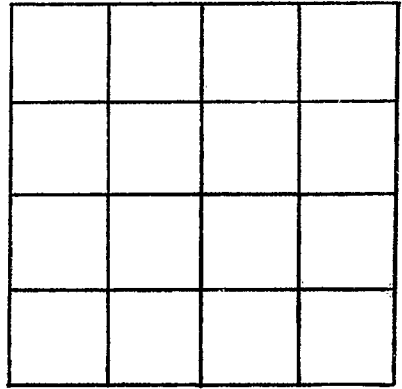

SECTION _____

Please indicate well location X.

ADDITIONAL INFORMATION

If more than one screen, show locations of each on sketch.