

MISSISSIPPI DEPARTMENT OF NATURAL RESOURCES

Bureau of Land and Water Resources

Southport Mall

P.O. Box 10631

Jackson, Mississippi 39201

WATER WELL DRILLERS LOG

CODED

WARREN CO.
L 35
2-17-84

Griner Drilling Service, Inc.

Warren

date well completed

firm name

county well located

LANDOWNER:

Marion Drilling
P.O. Box 3027
Daphne, Ala. 36526
(mailing address)

description of formations encountered

from

to

clay	0	40
sand, gravel	40	90
clay, hard rock	90	630
clay, rock	630	987
sand, shell	987	1240
clay, sand	1240	1415

WELL LOCATION: 1500' S + 1850' W

No. 1 sec. 29 T. 12 N. R. 5 E. 1/4 sec. 29
Federal Land Bank
Land Bank of Lewis
29 miles of Oak Ridge Field
(distance) (direction) (nearest town)

WELL PURPOSE: oilfield supply
(home, irrigation, municipal, industrial)

WELL COMPLETION DATA:

- (1) diameter (inches) 3"
- (2) total depth (feet) 1415'
- (3) static water level (feet) 140' ^{below} _{above} top of ground.
- (4) casing steel, 1218"
(material) (depth)
3"
(size) if telescope see back.
- (5) screen 84', 1134'
(length) (depth to top)
3" perforated
(size) (material)
- (6) pump 80
(HP) (yield gpm)
AC
(type power)
- (7) electric log —
(yes or no)
—
(organization running log)
- (8) how well bottom plugged orange peel

DRILLERS REMARKS:


DEPT. OF NATURAL RESOURCES
BUREAU OF LAND & WATER RESOURCES

FEB 24 1984

RECEIVED

If well telescopes please sketch and show depths.

GROUND LEVEL

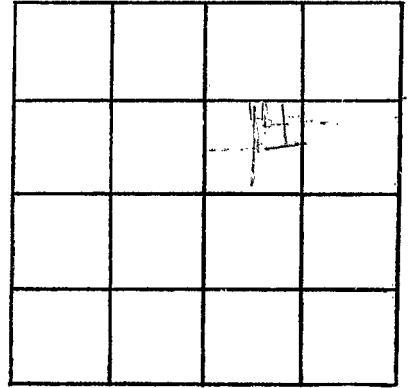

SECTION _____

Please indicate well location X.

ADDITIONAL INFORMATION

If more than one screen,
show locations of each on sketch.