

MISSISSIPPI DEPARTMENT OF NATURAL RESOURCES

Bureau of Land and Water Resources

Southport Mall

P.O. Box 10631

Jackson, Mississippi 39209

WATER WELL DRILLERS LOG

L-36
Warren

April 5 1985 E.M. Bud Cresswell Warren
 date well completed firm name county well located


LANDOWNER:	description of formations encountered	from	to
Riverside Farms Rt. 5 Box 313C Vicksburg (mailing address) MS.			
WELL LOCATION: sec. 24 T 86 N R 5 E AT FLOWERS (distance) miles (direction) of (nearest town)			
WELL PURPOSE: IRRIGATION (home, irrigation, municipal, industrial)			
WELL COMPLETION DATA:			
(1) diameter (inches) 8			
(2) total depth (feet) 55			
(3) static water level (feet) 28 below top of ground.			
(4) casing PVC 25 (material), 8 (depth), 8 (size) if telescope see back.			
(5) screen 20 (length), 25 (depth to top), 8" galv. wire (size), galv. wire (material)			
(6) pump 10 (HP), 100 (yield gpm)			
(7) electric log no (yes or no)			
(8) how well bottom plugged cap			
DRILLERS REMARKS:			

RECEIVED
 MAY - 6 1985

Department of Natural Resources
 Bureau of Land & Water Resources

If well telescopes please sketch and show depths.

GROUND LEVEL

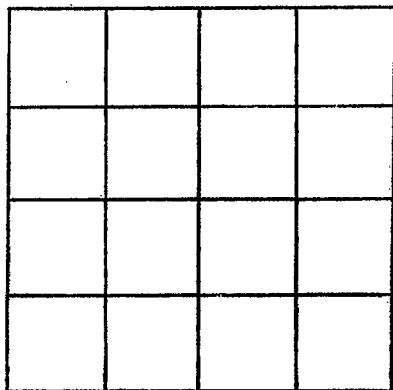

SECTION _____

Please indicate well location X.

ADDITIONAL INFORMATION

If more than one screen,
show locations of each on sketch.