

State Well Report

Part 1

Mississippi Department of Environmental Quality
Office of Land and Water Resources
P.O. Box 10631
Jackson, MS 39289-0631
(601)961-5210
(601)354-6938 (fax)

For Office Use Only:

Aquifer: L 45
Well #: _____
L. S. Elevation: _____
E-log #: _____

County: Warren
Permit #: _____
Driller: Gary Rayborn
Date drilling completed: 5/31/11

State Law requires that this report be prepared by the driller in detail and filed with the Department within 30 days of completion of drilling of the well.

Well Owner Information	Well Location
Owner Name: <u>Robert Short</u>	Latitude: <u>32° 23' 11.59"</u> Longitude: <u>90° 39' 18.37"</u>
Mailing Address: <u>420 Youngton Rd</u>	Method of Lat/Long (circle one): <u>Google Earth</u> Conventional Survey, _____
<u>Vicksburg MS 39183</u>	USGS quad; Hand-held GPS, Survey-grade GPS
City State Zip Code	<u>SW 1/4 SE 1/4 Sec 1 Twn 16N Rng 5E</u>
Telephone No. <u>(601) 688-6945</u>	Distance Direction Nearest Town <u>2</u> Miles <u>N/NE</u> of <u>Vicksburg Flowers</u>

Well Data

Purpose of Well (circle one): Home Industrial Public Supply Irrigation Fish Culture Other: _____

Date well drilling started: 5/31/11 Date well drilling completed: 5/31/11

If flowing, method of flow regulation: Valve _____ Other (describe) _____

Static Water Level: 45 feet above or below (circle one) land surface Date measured: 5/31/11

Method of Measurement (circle one) steel tape electric tape air line other: _____

Hole depth: 110' Well depth: 110' Well grouted to a depth of 10 feet

Type of grout (circle one): Cement Bentonite Mix

Casing length: 90 feet Casing diameter: 4 inches Type of casing: PVC

Screen length: 20 feet Screen diameter: 4 inches Type of screen: PVC

Screen slot size: .010 inches Setting depth: From 90 feet to 110 feet

Type of completion (circle all applicable): Gravel packed Underreamed Telescoped Open hole Natural Development

Other (describe): _____

Top of lap pipe or reduction in casing: _____ feet. If telescoped or more than one screen, describe on back of page

Logs run (circle all applicable): No log run Electric Gamma Ray Density Sonic Neutron Other: _____

Name of organization running log(s): _____

I certify that the well was drilled, constructed, and completed in accordance with all applicable requirements of the Mississippi Department of Environmental Quality and/or the Mississippi Department of Health regulations and state laws.

RAYBORN DRILLING, INC. 0-60
Print Name of Water Well Contractor and License No.

Signature of Water Well Contractor: [Signature] RECEIVED

JUN 15 2011
BY: OLWR

STATE WELL REPORT

Part 2

Pump Installer's Completion Report
 Mississippi Department of Environmental Quality
 Office of Land and Water Resources
 P.O. Box 10631
 Jackson, MS 39289-0631
 (601)961-5210
 (601)354-6938 (fax)

County: Warren
 Permit #: _____
 Driller: Gary Rayborn
 Date completed: 5-31-11

For Office Use Only:

Aquifer: _____
 Well #: _____
 Elevation: _____

This report should be prepared by the pump installer in detail and filed with the Department within 30 days of the installation of pump.

Well Owner Information	Well Location
Owner Name: <u>Robert Short</u>	Latitude: <u>32°23'11.59"N</u> Longitude: <u>90°39'18.37"W</u>
Mailing Address: <u>420 Youngton Rd</u>	Method of Lat/Long (circle one): <u>Google Earth</u> Conventional Survey, Survey-grade GPS
<u>Vicksburg MS 39183</u> City State Zip Code	USGS quad, Hand-held GPS, Survey-grade GPS _____ ¼ _____ ¼ Sec <u>1</u> Twn <u>16N</u> Rng <u>5E</u>
Telephone No. <u>(601) 638-6945</u>	Distance Direction Nearest Town <u>2</u> Miles <u>N/NE</u> of <u>Flowers</u> Vicksburg

Pump Type Circle one	Power Type Circle one
Air Lift Jet <input type="radio"/> Submersible <input checked="" type="radio"/>	Diesel Engine Gasoline Engine Natural Gas
Bucket Piston <input type="radio"/> Turbine <input type="radio"/>	Electric Motor <input checked="" type="radio"/> Hand <input type="radio"/> Tractor PTO <input type="radio"/>
Centrifugal Rotary <input type="radio"/> Flowing Well <input type="radio"/>	Windmill Other (specify): _____
Other (specify): _____	Horse Power Rating of Motor: <u>1.5</u>
Date Pump Installed: <u>5-31-11</u>	Setting Depth: <u>90</u> feet
Rated Pump Capacity: <u>20</u> Gallons Per Minute	Number of Stages: <u>11</u>

Pump Test Data	Method of Measuring Water Level Circle one
Date Well Tested: <u>5-31-11</u>	Air Line <input type="radio"/> Electric Measuring Line <input checked="" type="radio"/> Steel Tape <input type="radio"/>
Static Water Level (A): <u>45</u> Feet Below Land Surface	Other (specify): _____
Pumping Water Level (B): _____ Feet Below Land Surface	For flowing well, measured shut in head: _____ feet
Drawdown [(B) - (A)]: _____ Feet Below Land Surface	Well yielded <u>20</u> GPM with a drawdown of _____ feet after _____ hours of pumping
Test Pumping Rate: <u>20</u> Gallons Per Minute	
Duration of Pump Test (minimum 4 hours): _____ hours	

I HEREBY CERTIFY that the above statements are true to the best of my knowledge.

Gary Rayborn 0-60
 Print Name of Pump Installer and License No. (if applicable)

[Signature]
 Signature of Pump Installer

RECEIVED

JUN 15 2011

BY: OLWR


If well telescopes please sketch below and show depths.

Ground Level

Description of Formations Encountered	From	To
CHALK	0	75
COURSE SAND	75	110

If more than one screen, show location of each on sketch

Sketch the property layout and include the following: 1) the well location; 2) any permanent structures on the property that may aid in locating the well; 3) any roads, power lines, or other items that may aid in locating the property and the well; 4) indicate direction.

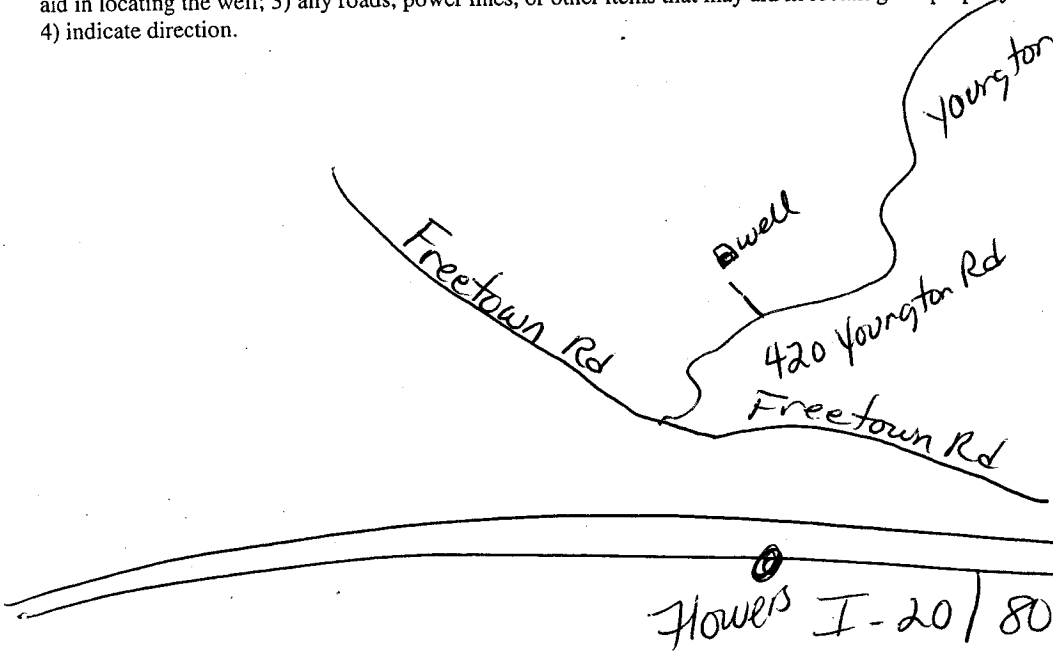

Landowner Name: _____



 Signature of Water Well Contractor

RECEIVED
 JUN 15 2011
 BY: OLWR