

L 3000  
8-29-60

WATER WELL DRILLERS LOG

L 300

Date: 8-29, 1960, Driller: Stuck County: Warren  
(Name)

(1) Owner of Land: King Merrill  
(Name)  
Bernie Lewis  
(Address) 16 16 5  
21

(2) Location: 1/4, 1/4, Sec. 21 T16R9  
4 miles East, of Bernie  
(distance) (direction) (Nearest Town)

(3) Topography: Flat  
(Hilly) (Flat) (Level)

(4) Purpose of Well: Stock  
(Domestic Irrigation  
Municipal, Industrial, Other)

Description & Color of Materials  
Sand, Clay, Red Clay, Shell, etc.

Thickness  
Feet

Depth  
Feet

0-65 Clay  
65-96 sand

Information upon completion of well:

(1) Diameter 2 inches.

(2) Total Depth 96 feet.

(3) Water Level 50 feet below top of ground.

(4) Cased to 90, Size 2


(5) Screen: Size 2, Length 6

(6) Were any formations sealed against pollution?  
no, no.

If YES depth of formation \_\_\_\_\_

Why \_\_\_\_\_

Drillers Remarks: \_\_\_\_\_

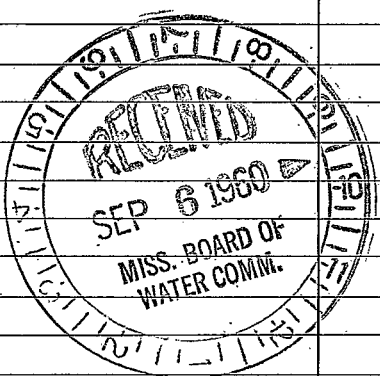

Well No.

(Use Back Side)

