

WARREN  
 K 2001  
 3-68

MISSISSIPPI  
 BOARD OF WATER COMMISSIONERS  
 416 North State Street  
 Jackson, Mississippi 39201

WATER WELL DRILLERS LOG

MARCH 7 1968 FERB FORE Warren  
 date well completed firm name county well located

LANDOWNER:  
Lawrence Elmore  
RT 5-Box 298 Vicksburg  
 (mailing address)

description of formations encountered	from	to
<u>Brown Sdy Cl</u>	<u>0</u>	<u>30</u>
<u>Sand</u>	<u>30</u>	<u>60</u>
<u>Red gravel</u>	<u>60</u>	<u>66</u>

WELL LOCATION:  
 sec 8 T 16 N R 5 E  
16 miles NE of Vicksburg  
 (distance) (direction) (nearest town)

WELL PURPOSE: Home  
 (home, irrigation, municipal, industrial)

WELL COMPLETION DATA:

(1) diameter (inches) 4 1/4

(2) total depth (feet) 66

(3) static water level (feet) 26 below above top of ground.

(4) casing Galv 61  
 (material) (depth)


5 If telescope see back.  
 (size)

(5) screen 5 61  
2" (length) (depth to top)  
SS  
 (size) (material)

(6) pump 1 10  
 (HP) (yield gpm)  
Elec  
 (type power)

(7) electric log No  
 (yes or no)  
None  
 (organization running log)

(8) BW Valve  
 how well bottom plugged

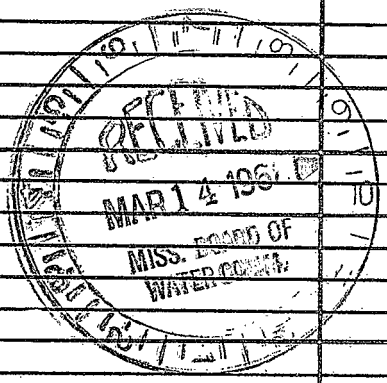


DRILLERS REMARKS:

If well telescopes please sketch and show depths.

GROUND LEVEL

ROAD

Big  
Black  
River

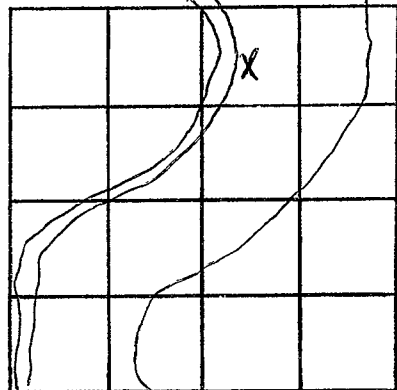

SECTION 8

Please indicate well location X.

ADDITIONAL INFORMATION

If more than one screen,  
show locations of each on sketch.