

CODED  
CODED

MISSISSIPPI  
BOARD OF WATER COMMISSIONERS  
416 North State Street  
Jackson, Mississippi 39201

WATER WELL DRILLERS LOG

Warren  
M15  
1-29-68

1-29 1968 BIG BLACK DRILLING Co. WARREN  
date well completed firm name county well located

LANDOWNER: ALBERT PAXTON

description of formations encountered from to

Hwy 61 - SOUTH

Top Soil 0' 7'

WICKSBURG, MISS.  
(mailing address)

CLUMBO 7' 42'

WELL LOCATION:

sec 35 T 15 N R 3 E  
near airport  
miles of  
(distance) (direction) (nearest town)

SAND & GRAVEL 42' 48'

WELL PURPOSE: CATTLE  
(home, irrigation, municipal, industrial)

WELL COMPLETION DATA:

(1) diameter (inches) 2"  
(2) total depth (feet) 48'  
(3) static water level (feet) 17 below  
top of ground.

(4) casing GALV, 43  
(material) (depth)  
2"  
(size) if telescope see back.

(5) screen 5, 43  
(length) (depth to top)  
2", STAINLESS STEEL  
(size) (material)

(6) pump 1 10 GAL  
(HP) (yield gpm)  
ELECTRIC  
(type power)

(7) electric log NO  
(yes or no)

(organization running log)

(8) how well bottom plugged BACK  
WASH VALVE

DRILLERS REMARKS:


CODED

JAN - 6 1969

MISS. BD. OF  
WATER COM.

If well telescopes please sketch and show depths.

GROUND LEVEL

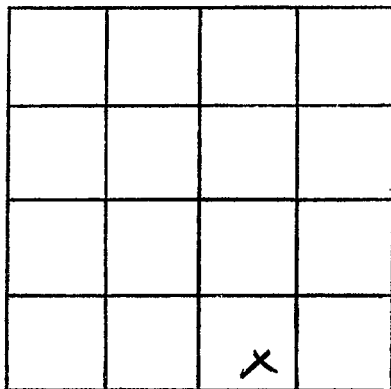

SECTION 35

Please indicate well location X.

ADDITIONAL INFORMATION

If more than one screen, show locations of each on sketch.