

WARREN

MS-GW-2692

MISSISSIPPI BOARD OF WATER COMMISSIONERS
416 North State Street
Jackson, Mississippi 39201

~~AA17~~
M17
3-13-75
Elog #125

WATER WELL DRILLERS LOG

3-13 date well completed 1975 Singer-Lemo Central Div firm name Warren county well located

LANDOWNER:
Fishers Ferry Water District
Vicksburg, Miss
(mailing address)


description of formations encountered	from	to
Brown Clay	0	34
Blue Clay	34	160
Lime Rock	160	161
Clay	161	167
Lime Rock + Sths. of Clay	167	210
Sand	210	215
Clay + Sand + Sths.	215	273
Sand	273	281
Clay	281	335
Hard Shale	335	355
Shale	355	458
Shale	458	475

WELL LOCATION:
sec. 42 T15 N R3 E S1
(distance) miles (direction) of (nearest town)

WELL PURPOSE: Domestic
(home, irrigation, municipal, industrial)

- WELL COMPLETION DATA:
- (1) diameter (inches) 10"
 - (2) total depth (feet) 438'
 - (3) static water level (feet) 125' below top of ground.
 - (4) casing Steel 365'
(material) (depth)
10" If telescope see back.
(size) 62' 86"
 - (5) screen 60' 365'
(length) (depth to top)
6" Stainless Steel WW
(size) (material)
 - (6) pump 25 250
(HP) (yield gpm)
Electric
(type power)
 - (7) electric log yes
(yes or no)
Miss. Gen. Survey
(organization running log)
 - (8) how well bottom plugged Valve

DRILLERS REMARKS:

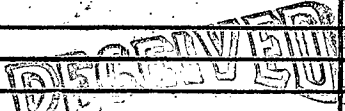

APR 14 1975

MISS. BD. OF WATER COMMISSIONERS



If well telescopes please sketch and show depths.

GROUND LEVEL

Large empty rectangular area for sketching ground level details.

SECTION

Please indicate well location X.

ADDITIONAL INFORMATION

Series of horizontal lines for providing additional information.

If more than one screen, show locations of each on sketch.