

WARREN  
 M22  
 3-17-81  
 E Log # 168

MISSISSIPPI  
 BOARD OF WATER COMMISSIONERS  
 416 North State Street  
 Jackson, Mississippi 39201

CODED

WATER WELL DRILLERS LOG

3-17 1981 date well completed  
 GUNN well ser WARREN firm name  
 county well located


LANDOWNER:  
 George Lee  
 (mailing address)

description of formations encountered	from	to
Sand & gravel	0	120

WELL LOCATION:  
 sec. 12 T 15 N R 3 E  
 (distance) miles (direction) of (nearest town)

WELL PURPOSE:  
 (home, irrigation, municipal, industrial)

- WELL COMPLETION DATA:
- (1) diameter (inches) 4"
  - (2) total depth (feet) 120
  - (3) static water level (feet) 50 below top of ground.
  - (4) casing PVC 50 (material) (depth)
  - 49 (size) if telescope see back.
  - (5) screen 20 50 (length) (depth to top)
  - 4 (size) PVC (material)
  - (6) pump 1/2 (HP) 1 (yield gpm)
  - (type power)
  - (7) electric log (yes or no) MRS (organization running log)
  - (8) how well bottom plugged Bank

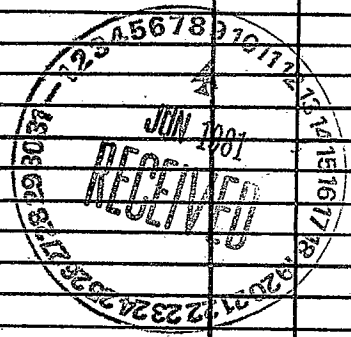

DRILLERS REMARKS:

