

MISSISSIPPI
BOARD OF WATER COMMISSIONERS
416 North State Street
Jackson, Mississippi 39201

WATER WELL DRILLERS LOG

JAN 3, 1968 Big Black Drilling Co WARREN
date well completed firm name county well located

LANDOWNER: Henry Board
P.O. & Vicksburg, Miss
(mailing address)

description of formations encountered	from	to
Red clay	0	30
Blue clay	30	54
Rock lime	54	56
Hard Blue clay	56	70
Rock with Blue clay	70	110
Blue shale	110	124
FLARE SAND	124	129
CLEAN SAND about 179	129	194
BACK TO shale	194	

WELL LOCATION:


sec. 35 T. 15 N. R. 3 E
5 miles South of Vicksburg
(distance) (direction) (nearest town)

WELL PURPOSE: Home
(home, irrigation, municipal, industrial)

WELL COMPLETION DATA:

- (1) diameter (inches) 2"
- (2) total depth (feet) 194'
- (3) static water level (feet) 54 ^{below}/_{above} top of ground
- (4) casing Galv. 194'
(material) (depth)
- (size) if telescope see back.
- (5) screen 10' ~~174'~~ 194'
(length) (depth to top)
- 2" stainless steel
(size) (material)
- (6) pump 1 8
(HP) (yield gpm)
- Elec
(type power)
- (7) electric log NO
(yes or no)
- (organization running log)
- (8) how well bottom plugged BACK
WASH VALVE

DRILLERS REMARKS:

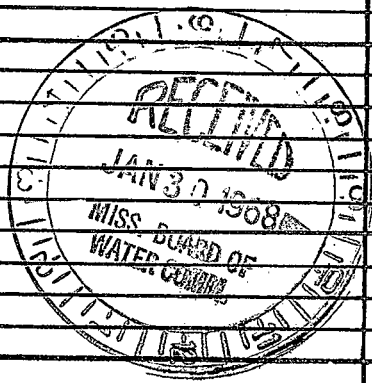

If well telescopes please sketch and show depths.

GROUND LEVEL

		X	

SECTION 35

Please indicate well location X.

ADDITIONAL INFORMATION

If more than one screen,
show locations of each on sketch.