

N

WATER WELL DRILLERS LOG

Warren
De Witt

11-10-64

Date: 11/10, 1964, Driller: Forest Drilling County De Witt
(Name)

(1) Owner of Land: George W. Tucker
(Name)
Vicksburg, Miss.
(Address)
(2) Location: 1/4, 1/4, Sec. T R
10 miles North, of Vicksburg
(distance) (direction) (Nearest Town)
(3) Topography:
(Hilly) (Flat) (Level)
(4) Purpose of Well: Home
(Domestic Irrigation
Municipal, Industrial, Other)


Description & Color of Materials Sand, Clay, Red Clay, Shell, etc.	Thick- ness Feet	Depth Feet:
<u>Brown Silt</u>	<u>0</u>	<u>25</u>
<u>Clay + Sth Gravel</u>		<u>40</u>
<u>Blue Clay</u>		<u>82</u>
<u>Sand + Shale</u>		<u>120</u>
<u>Rock + Sth. lime</u>		<u>169</u>
<u>Sand Shell + Clay</u>		<u>184</u>
<u>Sand + Shell</u>		<u>189</u>
<u>Shale</u>		<u>224</u>
<u>Sand + Sth. Shale</u>		<u>230</u>
<u>Shale</u>		<u>235</u>
<u>Sand (Sth. shale)</u>		<u>255</u>
<u>Sand</u>		<u>258</u>

Information upon completion of well:

(1) Diameter 2 inches.
(2) Total Depth 250 feet.
(3) Water Level 34 feet below top of ground.
(4) Cased to 240, Size 2"
(5) Screen: Size 2", Length 10 ft.
(6) Were any formations sealed against pollution?
 yes, ✓ no.

If YES depth of formation
Why

Drillers Remarks:

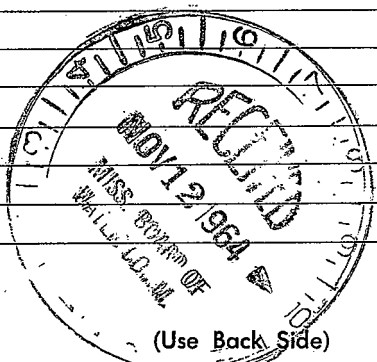

(Use Back Side)

Well No.

