

Warren  
N 11  
8-66

**CODED**

**WATER WELL DRILLERS LOG**

Date: August 11, 1966, Driller: Carlross Well Supply County Warren

(Name)

(1) Owner of Land: Hilldale Water Dist  
Well # 2  
Vicksburg, Mississippi

(2) Location: SW NE 1/4, NE 1/4, Sec. 11 15 4  
NE 1/4, NE 1/4, Sec. 10 T19E,

5 miles S.E. of Vicksburg  
(distance) (direction) (Nearest Town)

(3) Topography: \_\_\_\_\_  
(Hilly) (Flat) (Level)

(4) Purpose of Well: Municipal  
(Domestic Irrigation  
Municipal, Industrial, Other)

Information upon completion of well:

(1) Diameter 8 inches.

(2) Total Depth 443 feet.

(3) Water Level 172 feet below top of ground.

(4) Cased to 392, Size 8"

(5) Screen: Size 4", Length 46'

(6) Were any formations sealed against pollution?  
\_\_\_\_\_ yes, \_\_\_\_\_ no.

If YES depth of formation \_\_\_\_\_

Why \_\_\_\_\_


Drillers Remarks: \_\_\_\_\_

Pump HP 15

GPM 158

Type Power Elec 220

Description & Color of Materials Sand, Clay, Red Clay, Shell, etc.	Thick- ness Feet	Depth Feet
Red Clay	26'	26'
White Clay	14'	40'
Real Hard Blue Clay	14'	54'
Clay	16'	70'
Clay and Streaks Sand	14'	84'
Clay with Soft Streaks	32'	116'
Sand with Streaks Clay	24'	140'
Clay	7'	147'
Hard Sandy Shale	55'	202'
Sand	2'	204'
Lime Rock, Hard	4'	208'
Rock with Soft Spot	31'	239'
Rock	4'	243'
Sand	20'	263'
Sandy Clay	7'	270'
Clay	15'	285'
Sand	15'	300'
Sand, Shale or Rock	27'	327'
Real Fine Gray Sand & Streaks of Shale	57'	384'
Solid Sand	10'	394'
Real Fine Gray Sand & Streaks Shale	36'	430'
Sand Streaks	26'	456'
Clay and Streaks Sand	11'	467'

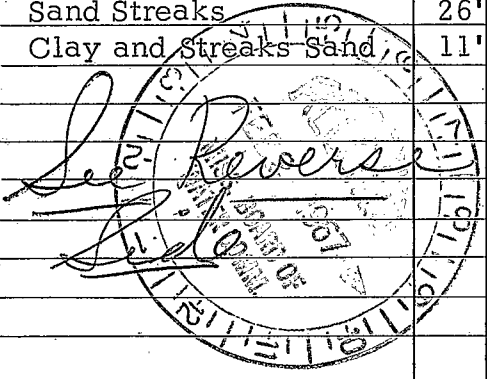

(Use Back Side)

Well No.



Barth & Associates, Inc.  
Consulting Engineers  
2906 North State Street  
Jackson, Mississippi 39216

OWNER:

Hilddale Water District  
Mr. Howard Swett, Jr., President  
Vicksburg, Mississippi