

Warren
N 15
12-68

MISSISSIPPI
 BOARD OF WATER COMMISSIONERS
 416 North State Street
 Jackson, Mississippi 39201
 WATER WELL DRILLERS LOG

CODED

CODED

date well completed 19 68 firm name BIG BLACK DRILLING Co county well located WARREN

LANDOWNER: KIRBY DAILY
FISHERS FEARY RD.
VICKSBURG, MISS
 (mailing address)

description of formations encountered	from	to
<u>BROWN CLAY</u>	<u>0</u>	<u>35</u>
<u>WHITE CHALK</u>	<u>35</u>	<u>50</u>
<u>LIME ROCK</u>	<u>50</u>	<u>52</u>
<u>WHITE CHALK</u>	<u>52</u>	<u>60</u>
<u>SHELL + CHALK</u>	<u>60</u>	<u>98</u>
<u>SAND</u>	<u>98</u>	<u>132</u>

WELL LOCATION:
 sec. 29 T. 15 N R. 4 E
8 miles S-E of VICKSBURG
 (distance) (direction) (nearest town)

WELL PURPOSE: HOME
 (home, irrigation, municipal, industrial)

WELL COMPLETION DATA:

- (1) diameter (inches) 2"
- (2) total depth (feet) 133'
- (3) static water level (feet) 100 ^{below} _{above} top of ground.
- (4) casing 2" GALV., 128',
 (material) (depth)
 _____ if telescope see back.
 (size)
- (5) screen 5', 128'
 (length) (depth to top)
2" 15', STAINLESS STEEL
 (size) (material)
- (6) pump 1 3
 (HP) (yield gpm)
electric
 (type power)
- (7) electric log NO
 (yes or no)

CODED

 (organization running log)

(8) how well bottom plugged: BACK
WASH VALVE


JAN - 6 1969

MISS. DD. UP

DRILLERS REMARKS:

If well telescopes please
sketch and show depths.

GROUND LEVEL

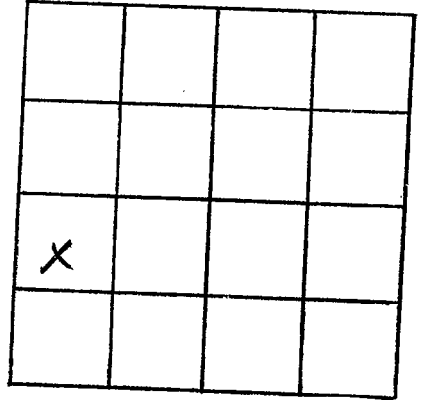

SECTION 29

Please indicate well location X.

ADDITIONAL INFORMATION

If more than one screen,
show locations of each on sketch.