

Warren
N 16
B-66

MISSISSIPPI BOARD OF WATER COMMISSIONERS

CODED

WATER WELL DRILLERS LOG

Date: August 11, 1966, Driller: Carloss Well Supply County: Warren
(Name)

- (1) Owner of Land: Hildale Water Dist.
Well # 1 (Name)
Vicksburg (Warren Co.), Miss. (Address)
- (2) Location: SW 1/4, SE 1/4, Sec. 3 T. 15.4 N. R. E.
5 miles S.E. of Vicksburg
(distance) (direction) (Nearest Town)
- (3) Topography: X
(Hilly) (Flat) (Level)
- (4) Purpose of Well: Municipal
(Domestic Irrigation
Municipal, Industrial, Other)

| Description & Color of Materials Sand, Clay, Red Clay, Shell, etc. | Thick- ness Feet | Depth Feet |
|---|------------------------|---------------|
| Yellow Clay | 35' | 35' |
| Yellow Sand | 20' | 55' |
| Hard Shale | 29' | 84' |
| Hard Shale w/Soft Spots | 61' | 145' |
| Hard Clay & Sand Strks. | 61' | 206 |
| Hard Clay w/Thin Soft | | |
| Rock | 29' | 235' |
| Vicksburg Lime | 35' | 270' |
| Fine Gray Sand | 30' | 300' |
| Sandy Shale | 80' | 380' |
| Sand | 83' | 463' |


Information upon completion of well:

- (1) Diameter 8 inches.
- (2) Total Depth 462' feet.
- (3) Water Level 176' feet below top of ground.
- (4) Cased to 396', Size 8"
- (5) Screen: Size 4", Length 64'
- (6) Were any formations sealed against pollution?
X yes, no.

If YES depth of formation Casing cemented
its entire length.
Why Std. Procedure

Drillers Remarks: Pump 15
GPM 151
Type Tower 220v.

CODED
See Reverse Side

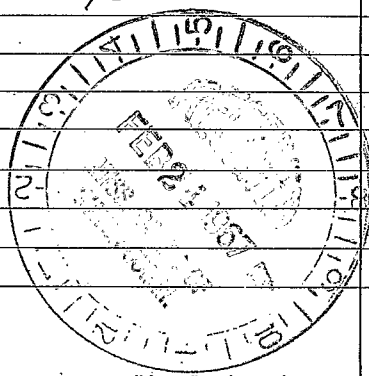

(Use Back Side)

Well No.



Hilldale Water District
Mr. Howard Swett, Jr., President
Vicksburg, Mississippi

OWNER:

Barth & Associates, Inc.
Consulting Engineers
2906 North State Street
Jackson, Mississippi 39216