

WARREN

N 19

7-28-62

## WATER WELL DRILLERS LOG

CODED

Date: 7/26 to 7/28/1962, Driller: Forest Drilling County: Warren

(Name)

(1) Owner of Land: Dave Ellison

(Name)

Rt. #5, Vicksburg, Miss.

(Address)

(2) Location: 1/4, 1/4, Sec. 2 T 15 R 410 miles Southeast, of V-burg.  
(distance) (direction) (Nearest Town)(3) Topography: x

(Hilly) (Flat) (Level)

(4) Purpose of Well: Domestic.(Domestic Irrigation  
Municipal, Industrial, Other)

## Information upon completion of well:

(1) Diameter: 2 inches.(2) Total Depth: 317 feet.(3) Water Level: 130 feet below top of ground.(4) Cased to: 307', Size: 2"(5) Screen: Size: 2", Length: 10'

(6) Were any formations sealed against pollution?


yes, x no.

If YES depth of formation: \_\_\_\_\_

Why: \_\_\_\_\_

Drillers Remarks: Good well.Description & Color of Materials  
Sand, Clay, Red Clay, Shell, etc.Thick-  
ness  
FeetDepth  
Feet

Brown clay.	42-	42
Clay.	30-	72
Blue clay.	10-	82
Clay.	50-	132
Clay & stks. shale.	30-	162
Clay.	8-	170
Rock.	5-	175
Clay.	3-	178
Rock.	4-	182
Rock & stks. clay.	30-	212
Rock & stks. shell.	10-	222
Sandy shell & stks. clay.	10-	232
Rock.	3-	235
Clay.	7-	242
Rock & clay.	10-	252
Shale.	20-	272
Clay & stks. sand.	28-	300
Sand. (Screen setting.)	17-	317

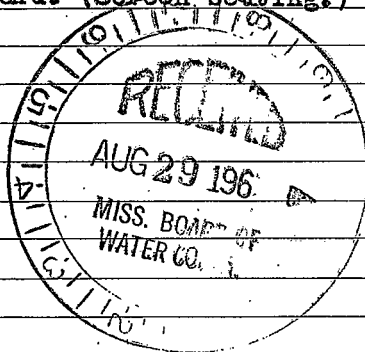

FOREST DRILLING SERVICE

P. O. Box 5717

PEARL BRANCH

JACKSON 8, MISS.

(Use Back Side)

Well #

Retain this copy for your office files.

