

WARREN
N 21
APRIL 29-72

MISSISSIPPI
 BOARD OF WATER COMMISSIONERS
 416 North State Street
 Jackson, Mississippi 39201

COL

WATER WELL DRILLERS LOG

April 29 1972 E.M. "Bud" Cresswell Warren
 date well completed firm name county well located

LANDOWNER:
 Robert M. Tompkins
 Vicksburg, Miss.
 (mailing address)

description of formations encountered	depth	
	from	to
Clay	0	45
Sand & silt clay	45	75
Sand	75	110

WELL LOCATION:
 sec 7 T 15 N R 4 E
 8 miles SE of Vicksburg
 (distance) (direction) (nearest town)

WELL PURPOSE: Home
 (home, irrigation, municipal, industrial)

- WELL COMPLETION DATA:**
- (1) diameter (inches) 2
 - (2) total depth (feet) 110
 - (3) static water level (feet) 40 below top of ground.
 - (4) casing Steel, 105 (material) (depth)
2 (size) if telescope see back.
 - (5) screen 5, 105 (length) (depth to top)
2, Standard (size) (material)
 - (6) pump 1, 12 (HP) (yield gpm)
0 (type power)
 - (7) electric log 0 (yes or no)
0
 (organization running log)

INDEXED

(8) how well bottom plugged
Steel plug


APR 25 1972

MISS. BD. OF
 WATER COMMISSIONERS

DRILLERS REMARKS:

If well telescopes please sketch and show depths.

GROUND LEVEL

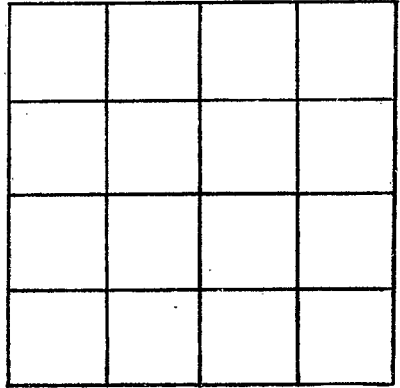

SECTION _____

Please indicate well location X.

ADDITIONAL INFORMATION

If more than one screen, show locations of each on sketch.