

WARREN

N23

8-29-75

Elg #134

8-29-75 date well completed

MISSISSIPPI BOARD OF WATER COMMISSIONERS 416 North State Street Jackson, Mississippi 39201

CODED

WATER WELL DRILLERS LOG

Jefcoat firm name

Warren county well located

LANDOWNER: Jack Cook 816 Westburg MS

(mailing address)

WELL LOCATION:

sec 22 T 15 N R 4 E 11 miles S/E of Vicksburg (distance) (direction) (nearest town)

WELL PURPOSE: home (home, irrigation, municipal, industrial)

WELL COMPLETION DATA:

- (1) diameter (inches) 4"
(2) total depth (feet) 1
(3) static water level (feet) below above top of ground.
(4) casing PVC, 228 (material) (depth) 4" (size) if telescope see back.
(5) screen 4" (length) 228 (depth to top) 4" (size) PVC (material)
(6) pump 0 (HP) 0 (yield gpm) AC (type power)
(7) electric log yes (yes or no)
(organization running log)
(8) how well bottom plugged

description of formations encountered

Table with 2 columns: from, to. Rows: Clay (0 to 65), sand (65 to 85), Clay (85 to 138), fine sand (138 to 150), shale (150 to 170), Lime Rock (170 to 228), fine sand (228 to 248)

CODED


NO WELL MADE RECEIVED MAY 19 1977

DRILLERS REMARKS:

MISS. BD. OF WATER COMM

If well telescopes please sketch and show depths.

GROUND LEVEL

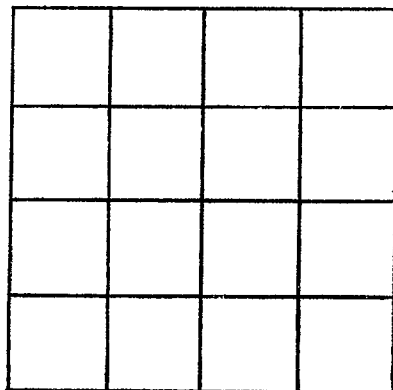

SECTION _____

Please indicate well location X.

ADDITIONAL INFORMATION

If more than one screen,
show locations of each on sketch.