

BOARD OF WATER COMMISSIONERS

416 North State Street

Jackson, Mississippi 39201

WARREN

N26

124976

Elog #192

WATER WELL DRILLERS LOG

CODED

10/4

19

76 Jerry Guinn

firm name

WARREN

county well located

LANDOWNER:

A. H. Brown  
Albert H. Brown  
RT. 5

description of formations encountered

from

to

Sand & Gravel

0

120

Clay

120

170

Lime

170

240

Sand

240

403

Vicksburg, Ms.

(mailing address)

WELL LOCATION:

sec. 24 T. 15 N. R. 4 E

10 miles SE of Vicksburg  
(distance) (direction) (nearest town)

WELL PURPOSE:

Home  
(home, irrigation, municipal, industrial)

WELL COMPLETION DATA:

- (1) diameter (inches) 4
- (2) total depth (feet) 403
- (3) static water level (feet) 124 below top of ground.
- (4) casing IRON, 380',  
(material) (depth)  
4" if telescope see back.  
(size)
- (5) screen 20', 400'  
(length) (depth to top)  
2" STAINLESS STEEL  
(size) (material)
- (6) pump 1 10  
(HP) (yield gpm)  
electricity  
(type power)
- (7) electric log YES  
(yes or no)  
Ms. Geological Survey  
(organization running log)
- (8) how well bottom plugged

CODED


RECEIVED  
DEC 9 1976

DRILLERS REMARKS:

MISS. BD. OF WATER COMM.

If well telescopes present, sketch and show depths.

GROUND LEVEL

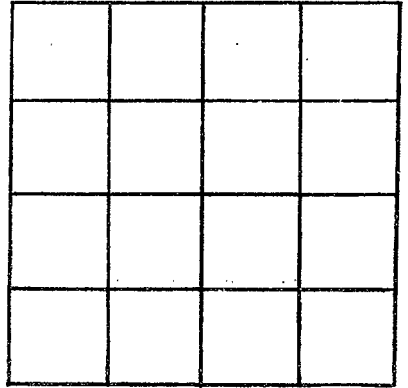

SECTION \_\_\_\_\_

Please indicate well location X.

ADDITIONAL INFORMATION

If more than one screen, show locations of each on sketch.