

WARREN

N33

5-25-83

Eloc #180

5/250

date well completed

MISSISSIPPI DEPARTMENT OF NATURAL RESOURCES
DEPT. OF NATURAL RESOURCES
BUREAU OF LAND AND WATER RESOURCES

Bureau of Land and Water Resources

Southport Mall

P.O. Box 10631

Jackson, Mississippi 39209

JUL 24 1983

CODE

RECEIVED

WATER WELL DRILLERS LOG

83 Jack C. Durr

well Ser.

Warren

firm name

county well located

LANDOWNER:

Herbert Downing

(mailing address)

WELL LOCATION:

sec 35 T15 N

R 4 E

5 miles Northeast Neeshaw

WELL PURPOSE:

Plama (home, irrigation, municipal, industrial)

WELL COMPLETION DATA:

- (1) diameter (inches) 4 in
- (2) total depth (feet) 442 ft
- (3) static water level (feet) 133 below top of ground.
- (4) casing P.V.C., 320 330 (material), (depth)
- 4 in (size) if telescope see back.
- (5) screen 20 ft, 330 (length), (depth to top)
- 2 in, P.V.C. (size), (material)
- (6) pump 2 HP, 20 (HP), (yield gpm)
- Electric (type power)
- (7) electric log yes (yes or no)
- m.c.d.s. (organization running log)
- (8) how well bottom plugged Back wash valve

description of formations encountered

from

to


Red sand & gravel	0	100
mgd & shell	122	188
Sand	180	200
Blue clay	200	260
Sand & shell	260	400

CODED

DRILLERS REMARKS:

If well telescopes please
sketch and show depths.

GROUND LEVEL

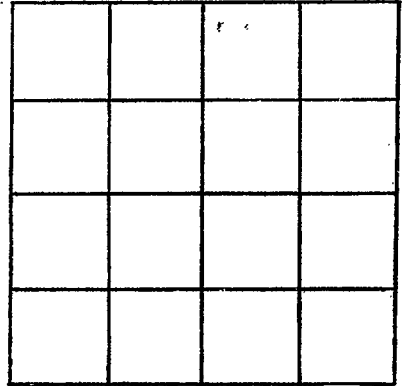

SECTION _____

Please indicate well location X.

ADDITIONAL INFORMATION

If more than one screen,
show locations of each on sketch.