

WARREN

WELL DRILLERS LOG

Date June 1 1965, Driller Creech & Cresswell County Warren

N 2005
6-1-65

(Name)

(1) Owner of Land: Beckwith, W. C., Dist. No. 2
(Name)
Vicksburg, Miss.
(Address)

(2) Location: 1/4, 1/4, Sec. 14 T5N R4E
_____ miles _____ of _____
(distance) (direction) (Nearest Town)

(3) Topography: _____
(Hilly) (Flat) (Level)

(4) Purpose of Well: Test
(Domestic Irrigation
Municipal, Industrial, Other)

Description & Color of Materials Sand, Clay, Red Clay, Shell, etc.	Thick- ness Feet	Depth Feet
<u>Clay</u>	<u>30</u>	<u>30</u>
<u>Sand</u>	<u>150</u>	<u>180</u>
<u>Shale</u>	<u>60</u>	<u>240</u>
<u>Shale</u>	<u>120</u>	<u>360</u>
<u>Sand</u>	<u>150</u>	<u>460</u>
<u>Blue Clay</u>	<u>40</u>	<u>500</u>

Information upon completion of well:

(1) Diameter 3 inches.

(2) Total Depth 500 feet.

(3) Water Level _____ feet below top of ground.

(4) Cased to _____, Size _____.


(5) Screen: Size _____, Length _____.

(6) Were any formations sealed against pollution?
_____ yes, _____ no.

If YES depth of formation _____

Why _____

Drillers Remarks: _____

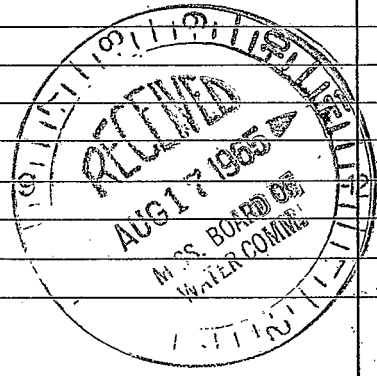

(Use Back Side)

Well No.

