

Date: June 9, 1965, Driller: Crest Cresswell County: Warren
6-9-65 (Name)


(1) Owner of Land: Hilldale Wb. Dist #1-3
(Name)
Vicksburg, Miss.
(Address)
(2) Location: 1/4, 1/4, Sec. 24 15th R4E
_____ miles _____ of _____
(distance) (direction) (Nearest Town)
(3) Topography: _____
(Hilly) (Flat) (Level)
(4) Purpose of Well: Test
(Domestic Irrigation
Municipal, Industrial, Other)

Description & Color of Materials Sand, Clay, Red Clay, Shell, etc.	Thick- ness Feet	Depth Feet
<u>Clay</u>	<u>40</u>	<u>40</u>
<u>Gravel</u>	<u>40</u>	<u>80</u>
<u>Rock. Lime & Shell</u>	<u>80</u>	<u>160</u>
<u>Gray Shale</u>	<u>85</u>	<u>245</u>
<u>Coar. Sand</u>	<u>135</u>	<u>380</u>
<u>Blue Clay</u>	<u>20</u>	<u>400</u>

Information upon completion of well:

(1) Diameter 3 7/8 inches.
(2) Total Depth 400 feet.
(3) Water Level 50R feet below top of ground.
(4) Cased to _____, Size _____
(5) Screen: Size _____, Length _____
(6) Were any formations sealed against pollution?
_____ yes, _____ no.

If YES depth of formation _____
Why _____
Drillers Remarks: _____

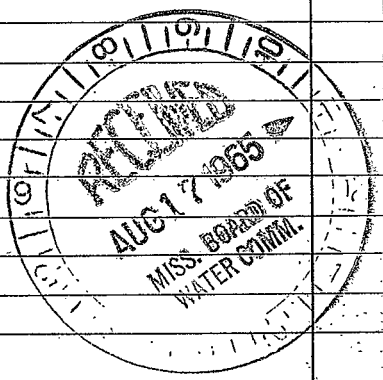

(Use Back Side)

Well No.

