

Warren
 N 2007
 3-67

MISSISSIPPI
 BOARD OF WATER COMMISSIONERS
 416 North State Street
 Jackson, Mississippi 39201

WATER WELL DRILLERS LOG

3-10-1967 date well completed
 Just Drilling firm name
 Warren county well located

LANDOWNER: Hamilton Ler
 3229 Halls Ferry Rd.
 Uicksburg,
 Miss.
 (mailing address)


WELL LOCATION:
 sec 29 T 15 N R 4 E
 S W
 6 miles 2 E of Uicksburg
 (distance) (direction) (nearest town)

WELL PURPOSE:
 (home, irrigation, municipal, industrial)

WELL COMPLETION DATA:

- (1) diameter (inches) 4
- (2) total depth (feet) 388
- (3) static water level (feet) 204 below top of ground.
- (4) casing Black pipe 368 (material) (depth)
 4" (size) if telescope see back.
- (5) screen 20 ft (length) (depth to top)
 2" (size) (material)
- (6) pump 2 Sub - 15 (HP) (yield gpm)
 Elect. (type power)
- (7) electric log ~~No~~ No (yes or no)
- (8) how well bottom plugged Backwash Valve

description of formations encountered	from	to
Brown Clay	0	20
Hard Clay		40
Clay + Rock		102
Clay + sh. Shell		122
fine sand + sh. fine shell		204
Shale + Rock		244
Rock + Shale		305
Shale + sh. Rock		327
Shale		337
Fine sand + Shale		368
Fine sand + sh. Clay		388
Clay + sh. fine sand		409

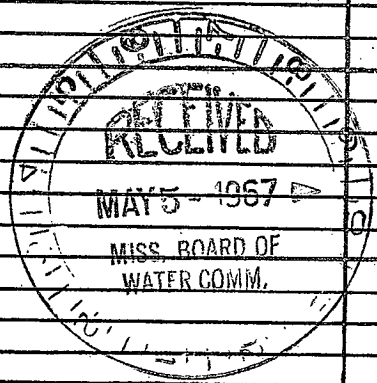

DRILLERS REMARKS:

