

**MISSISSIPPI  
BOARD OF WATER COMMISSIONERS**  
416 North State Street  
Jackson; Mississippi 39201

**WATER WELL DRILLERS LOG**

Warren  
N 2008  
4-67

4-10 1967 **FB FORE** Warren Co.  
date well completed firm name county well located

LANDOWNER: **Herbert  
Frank-Poole Sr.**  
**Rt-1-241C-Vicksburg, Miss**  
(mailing address)


WELL LOCATION:  
sec **20** T **15** N R **4** E  
**6** miles **SE** of **Vicksburg**  
(distance) (direction) (nearest town)

WELL PURPOSE: **Home**  
(home, irrigation, municipal, industrial)

WELL COMPLETION DATA:

- (1) diameter (inches) **4 1/4"**
- (2) total depth (feet) \_\_\_\_\_
- (3) static water level (feet) \_\_\_\_\_ below  
top of ground. above
- (4) casing \_\_\_\_\_ (material) \_\_\_\_\_ (depth) \_\_\_\_\_  
\_\_\_\_\_ if telescope see back.  
(size)
- (5) screen \_\_\_\_\_ (length) \_\_\_\_\_ (depth to top) \_\_\_\_\_  
\_\_\_\_\_ (size) \_\_\_\_\_ (material)
- (6) pump \_\_\_\_\_ (HP) \_\_\_\_\_ (yield gpm) \_\_\_\_\_  
\_\_\_\_\_ (type power)
- (7) electric log \_\_\_\_\_ (yes or no) \_\_\_\_\_  
\_\_\_\_\_ (organization running log)
- (8) how well bottom plugged **no**

description of formations encountered	from	to
Brown Sh. Cl	0	31
Brown Sh. Cl	31	47
Green & White Sh. Cl	47	48
Sd. rock	48	49
Blue Cl Hard	49	98
Sd. rock	98	106
Sd. rock	106	107
Black Cl - Lignite	107	108
Blue Cl	108	173
Sd. rock + Bl. Cl	173	181
Sd.	181	182
Hard Cl	182	214
Sd. rock	214	216
Sd. Cl	216	217
Sd. rock + Cl streak	217	219
Sd. rock + Cl streak	219	240
Sd. rock	240	250
Sd. rock	250	260
Sd. rock	260	263
Sd. rock	263	270
Sd. rock	270	280
Sd. rock	280	281
Sd. rock + Bl. Cl	281	290
Sd. rock	290	300
Blue Cl	300	320
Sd. rock	320	323
Sd. rock	323	326
Sd. rock	326	333
Sd. rock + Bl. Cl	333	343
Sd. rock	343	362

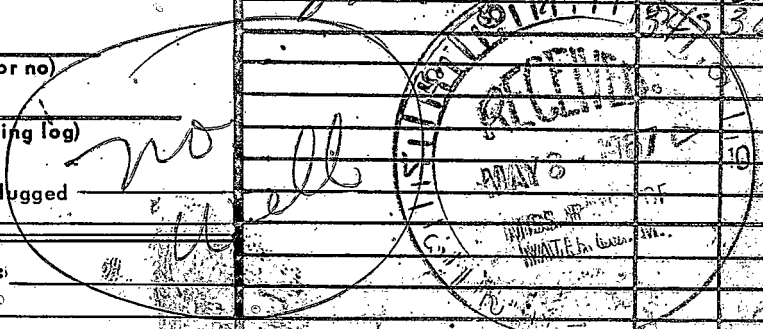

DRILLERS REMARKS:

If well telescopes please sketch and show depths.

GROUND LEVEL

			X

SECTION 20

Please indicate well location X.

ADDITIONAL INFORMATION

If more than one screen, show locations of each on sketch.