

Warren
 N 2009
 6-67
 Elec 109
 6/10/67

MISSISSIPPI
 BOARD OF WATER COMMISSIONERS
 416 North State Street
 Jackson, Mississippi 39201

WATER WELL DRILLERS LOG

19 Water Wells, Inc. Warren
 G. Cox firm name county well located

LANDOWNER: B. Fenwick
1612 Broadwell Drive
Vicksburg, Miss.
 (mailing address)

| description of formations encountered | from | to |
|--|------|-----|
| Loes Deposits | 0 | 53 |
| white clay | 53 | 79 |
| Blue Clay | 79 | 197 |
| Grey shale - Sand streaks | 197 | 215 |
| Green lime Rock - Very hard | 215 | 217 |
| Salt Grey (Green) Limestone | 217 | 220 |
| Vicksburg Limestone - Hard | 220 | 270 |
| Grey - Green Limestone - Grey streaks of sand in lower part - largely consolidated sandstone to 220' | | |
| Sandy Shale with fossils | 270 | 282 |
| Blue Clay | 282 | 333 |
| Sandy shale | 333 | 356 |
| Grey Clay & shale | 356 | 427 |


WELL LOCATION:
 sec. 30 T. 15 N R. 4 E
6 1/4 miles S.E. of Vicksburg
 (distance) (direction) (nearest town)

WELL PURPOSE: HOME
 (home, irrigation, municipal, industrial)

WELL COMPLETION DATA:


- (1) diameter (inches) 4 x 2
- (2) total depth (feet) 428
- (3) static water level (feet) 149 below top of ground.
- (4) casing 4" 253'
 (material) (depth)
- (5) screen 36' 253'
 (length) (depth to top)
2" Stainless Steel
 (size) (material)
- (6) pump 3/4 12
 (HP) (yield gpm)
220 volts
 (type power)
- (7) electric log yes
 (yes or no)
U.S.G.S
 (organization running log)
- (8) how well bottom plugged:
Back-wash drive

DRILLERS REMARKS: NO Sand
only sandy shale
Elevation 240 feet

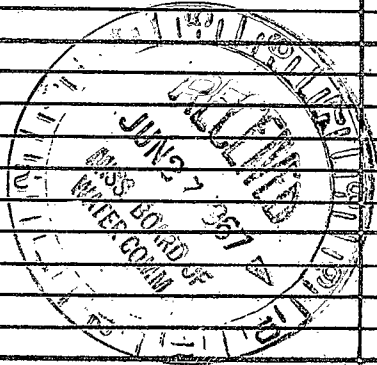

If well telescopes please sketch and show depths.

GROUND LEVEL

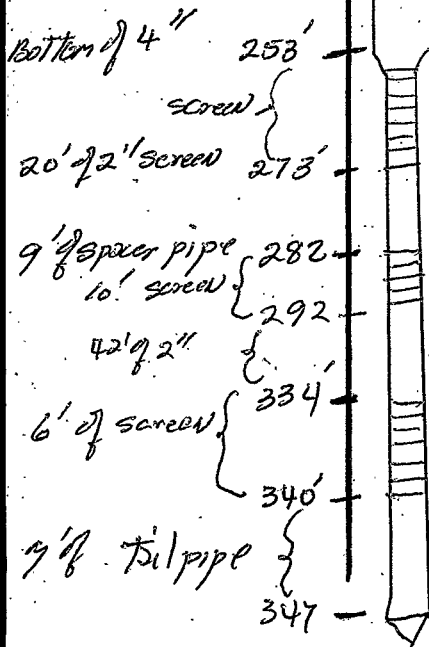

R 4 E

| | | | |
|-----|--|--|--|
| | | | |
| | | | |
| ⊗ ? | | | |
| | | | |

T15N

SECTION 30

Please indicate well location X.

ADDITIONAL INFORMATION

If more than one screen, show locations of each on sketch.