

MISSISSIPPI  
BOARD OF WATER COMMISSIONERS  
416 North State Street  
Jackson, Mississippi 39201

**WATER WELL DRILLERS LOG**

Warren  
N 20010  
68

19 68 EB FORE Warren  
date well completed firm name county well located

LANDOWNER: R. K. Donnell  
604 CAIN Ridge Rd.  
Vicksburg, Miss  
(mailing address)


WELL LOCATION:  
sec 30 T 15 N R 4 E  
8 miles 8 Duckburg  
(distance) (direction) (nearest town)

WELL PURPOSE: Home  
(home, irrigation, municipal, industrial)

WELL COMPLETION DATA:

- (1) diameter (inches) 4 1/4
- (2) total depth (feet) 126
- (3) static water level (feet) 107 below top of ground.
- (4) casing Galv, 121,  
(material) (depth)  
         if telescope see back.  
(size)
- (5) screen 5, 121  
(length) (depth to top)  
2, SS.  
(size) (material)
- (6) pump 1 4  
(HP) (yield gpm)  
Elec  
(type power)
- (7) electric log NO  
(yes or no)  
NONE  
(organization running log)
- (8) how well bottom plugged BW Valve

| description of formations encountered | from       | to         |
|---------------------------------------|------------|------------|
| <u>Brown Sdy Cl</u>                   | <u>0</u>   | <u>44</u>  |
| <u>White Clay</u>                     | <u>44</u>  | <u>69</u>  |
| <u>White Sand</u>                     | <u>67</u>  | <u>70</u>  |
| <u>Sd Rock &amp; White Cl</u>         | <u>70</u>  | <u>76</u>  |
| <u>Blue Cl</u>                        | <u>76</u>  | <u>120</u> |
| <u>Sand</u>                           | <u>120</u> | <u>126</u> |

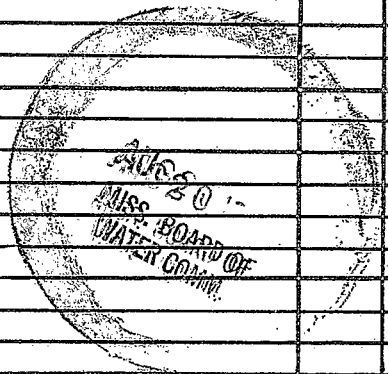

DRILLERS REMARKS:

If well telescopes please sketch and show depths.

GROUND LEVEL

|  |  |   |  |
|--|--|---|--|
|  |  | X |  |
|  |  |   |  |
|  |  |   |  |
|  |  |   |  |

SECTION \_\_\_\_\_

Please indicate well location X.

ADDITIONAL INFORMATION

If more than one screen,  
show locations of each on sketch.