

Warren
 N 2011
 8-68

MISSISSIPPI
 BOARD OF WATER COMMISSIONERS
 416 North State Street
 Jackson, Mississippi 39201

WATER WELL DRILLERS LOG

Aug 19 68 E B Jan Warren
 date well/completed firm name county well located

LANDOWNER: Mrs Joan
 Strubling
 Weicksburg Miss -
 (mailing address)

description of formations encountered	from	to
Brown sly @	0	33
Blue @	33	124
Sand fine	124	130


WELL LOCATION:
 sec 30 T 15 N R 4 E
 8 miles S of Weicksburg
 (distance) (direction) (nearest town)

WELL PURPOSE: Home
 (home, irrigation, municipal, industrial)

WELL COMPLETION DATA:


- (1) diameter (inches) 4 1/4
- (2) total depth (feet) 130
- (3) static water level (feet) 120 below above top of ground.
- (4) casing Galv, 125,
 (material) (depth)
 _____ If telescope see back.
 (size)
- (5) screen 5, 125
 (length) (depth to top)
2, SS
 (size) (material)
- (6) pump 1 2
 (HP) (yield gpm)
Elec
 (type power)
- (7) electric log No
 (yes or no)
None
 (organization running log)
- (8) how well bottom plugged BWD

DRILLERS REMARKS:

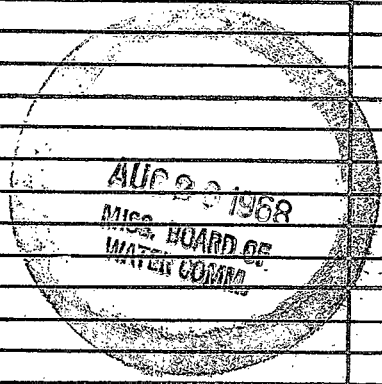

If well telescopes please sketch and show depths.

GROUND LEVEL

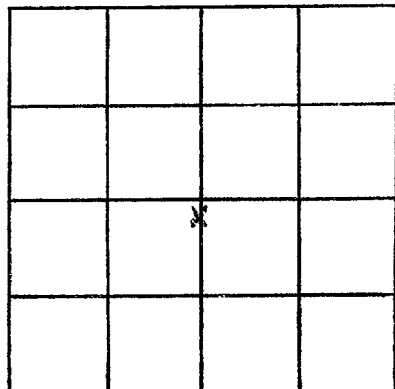

SECTION 30

Please indicate well location X.

ADDITIONAL INFORMATION

If more than one screen, show locations of each on sketch.