

**WARREN**  
 No. 2018  
 4-23-76

MISSISSIPPI  
 BOARD OF WATER COMMISSIONERS  
 416 North State Street  
 151K Jackson, Mississippi 39201

**WATER WELL DRILLERS LOG**

4-23 date well completed  
 1975 *Apfheat Drilling Co.* firm name  
 Warren county well located

LANDOWNER:  
*Clay Sanders*  
*Wicksburg, MS.*  
 (mailing address)

WELL LOCATION: *Proctor West.*  
 sec. *15* T. *15* N. R. *4* E. S. *1* E. *15* N.  
 7 miles (distance) S/E of *Wicksburg* (nearest town)

description of formations encountered	depth	
	from	to
<i>Clay</i>	0	30
<i>Sand</i>	30	96
<i>Gravel</i>	96	118
<i>S. Clay</i>	118	116
<i>Sand</i>	116	180

WELL PURPOSE: *Home*  
 (home, irrigation, municipal, industrial)

*2 1/2 mile south of Warren Central school in S.E. 15 N*

WELL COMPLETION DATA:

(1) diameter (inches) 2"

(2) total depth (feet) 180

(3) static water level (feet) 118 below top of ground.

(4) casing P.V.C. (material), 180 (depth)  
 (size) if telescope see back.

(5) screen 10 (length), 170 (depth to top)  
2" (size), P.V.C. (material)

(6) pump 1 (HP), 10 (yield gpm)  
A.C. (type power)

(7) electric log no (yes or no)  
 (organization running log)

(8) how well bottom plugged back wash


**RECEIVED**  
 JUL - 9 1976

DRILLERS REMARKS:

MISS. BD. OF WATER COMMISSIONERS

If well telescopes please  
sketch and show depths.

GROUND LEVEL

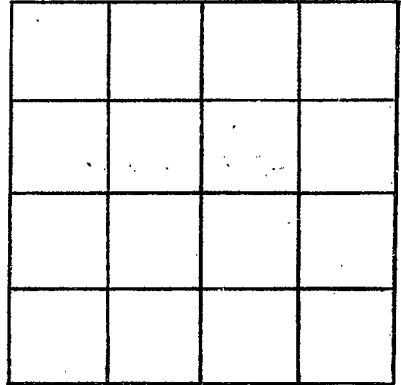

SECTION \_\_\_\_\_

Please indicate well location X.

ADDITIONAL INFORMATION

If more than one screen,  
show locations of each on sketch.