

Warren  
 N 2013  
 6-22-79

MISSISSIPPI  
 BOARD OF WATER COMMISSIONERS  
 416 North State Street  
 Jackson, Mississippi 39201

WATER WELL DRILLERS LOG

6/22 date well completed      79 E.M. "Bud" Cresswell firm name      Warren county well located

LANDOWNER:	description of formations encountered	from	to
A.L. Jordan Bovina, Ms. (mailing address)			
WELL LOCATION:			
sec. 1 T 15 N R 4 E			
3 miles South of Bovina (distance) (direction) (nearest town)			
WELL PURPOSE: Home (home, irrigation, municipal, industrial)			
WELL COMPLETION DATA:			
(1) diameter (inches) 2			
(2) total depth (feet) 135			
(3) static water level (feet) 120 below top of ground.			
(4) casing PVC, 125, (material) (depth)			
2 (size) if telescope see back.			
(5) screen 10, 125 (length) (depth to top)			
2 PVC (size) (material)			
(6) pump 1, 5 (HP) (yield gpm)			
0 (type power)			
(7) electric log No (yes or no)			
(organization running log)			
(8) how well bottom plugged Steel plug			
DRILLERS REMARKS:			


Miss. Board of Water Comm.

JUL 5 1979

RECEIVED

If well telescopes please sketch and show depths.

GROUND LEVEL

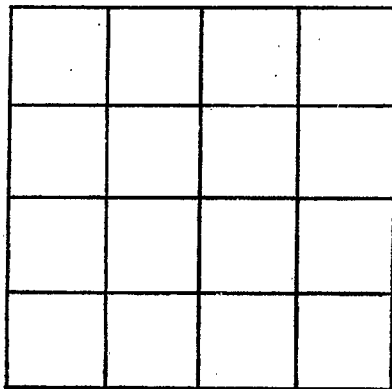

SECTION \_\_\_\_\_

Please indicate well location X.

ADDITIONAL INFORMATION

If more than one screen, show locations of each on sketch.