

MISSISSIPPI DEPARTMENT OF NATURAL RESOURCES

Bureau of Land and Water Resources

Southport Mall

P.O. Box 10631

Jackson, Mississippi 39209

WATER WELL DRILLERS LOG

WARREN
N 2014
3/29/81

29 March 1981 J.L. Gatz Explorations Warren
date well completed firm name county well located

LANDOWNER: C.J. Fisher
Miss 27 South
Vicksburg, Ms 39180
(mailing address)

description of formations encountered	from	to
Clayey Silt (Loess)	-0-	36'
Gravelly sand	36	64'
Sand med to fine	64	78'
Sandy gravel	78	81'
Clay, sandy, blue	81	82.5'
Bottom of hole		

WELL LOCATION:
sec. 25 T-15 N R-5 E
7.5 miles SE of Vicksburg
(distance) (direction) (nearest town)

WELL PURPOSE: HOME
(home, irrigation, municipal, industrial)

WELL COMPLETION DATA:

- (1) diameter (inches) 2-in
- (2) total depth (feet) 81.0 ft
- (3) static water level (feet) 37 below above top of ground.
- (4) casing PVC 76.0
(material) (depth)
(size) If telescope see back.
- (5) screen 5.0 76.0
(length) (depth to top)
2 PVC wire wrapped
(size) (material)
- (6) pump 1 12
(HP) (yield gpm)
220 Elec
(type power)
- (7) electric log No
(yes or no)
(organization running log)
- (8) how well bottom plugged PVC Cap

DEPT. OF NATURAL RESOURCES
BUREAU OF LAND & WATER RESOURCES


MAR 17 1981

RECEIVED

DRILLERS REMARKS:

If well telescopes please sketch and show depths.

GROUND LEVEL

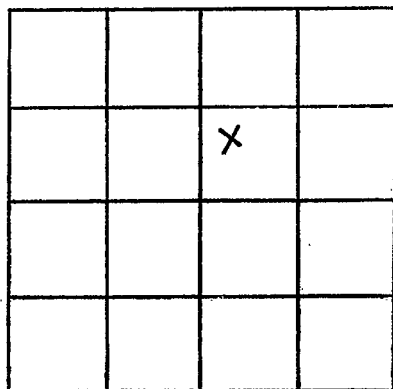

SECTION 25

Please indicate well location X.

ADDITIONAL INFORMATION

If more than one screen,
show locations of each on sketch.