

WARREN

WATER WELL DRILLERS LOG

10-3-62

Date: 10/1 to 3, 1962, Driller: James McGee County: Warren

(Name)

(1) Owner of Land: Mr. & Mrs. A. G. Peck  
 This well located down Hwy. 27, South  
 Rt. ? Box 173, Vicksburg, Miss.  
 (Name)  
 Go until just before you get to Mr.  
 (Address)  
 (2) Location: 1/4, 1/4, Sec. T R  
 Tingle's Gro. store, turn left and  
10 miles South of V-burg.  
 (distance) (direction) (Nearest Town)  
 about 1 mile.  
 (3) Topography: X  
 (Hilly) (Flat) (Level)  
 (4) Purpose of Well: Domestic.  
 (Domestic Irrigation  
 Municipal, Industrial, Other)

Description & Color of Materials Sand, Clay, Red Clay, Shell, etc.	Thick- ness Feet	Depth Feet
Brown clay.	62	62
Blue clay.	24	86
Fine sand.	6	92
Clay & stks. sand.	10	102
Clay.	80	182
Clay & shell.	10	192
Clay.	3	195
Rock.	43	238
Fine sand.	9	247
Clay.	65	312
Clay & stks. sand.	20	332
Fine sand & stks. clay.	26	358
Fine sand.	22	380
Good sand. (Screen set.)	29	409

Information upon completion of well:

- (1) Diameter 2 inches.
- (2) Total Depth 409 feet.
- (3) Water Level 125 feet below top of ground.
- (4) Cased to 399', Size 2"
- (5) Screen: Size 2", Length 10'
- (6) Were any formations sealed against pollution?  
no, X yes.

If YES depth of formation \_\_\_\_\_

Why: \_\_\_\_\_


Drillers Remarks: Good well.

FOREST DRILLING SERVICE

P. O. Box 5717

PEARL BRANCH

JACKSON 8, MISS.

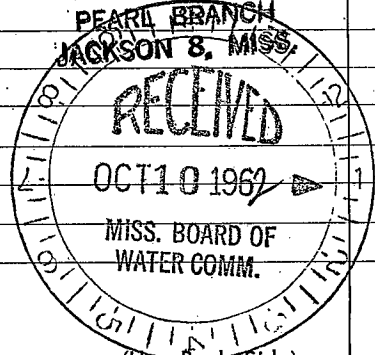

(Use Back Side)

Well No.

