

WARREN

02

7-12-76

E 4^{1/2} # 141

MISSISSIPPI BOARD OF WATER COMMISSIONERS
416 North State Street
Jackson, Mississippi 39201

CODED

WATER WELL DRILLERS LOG

2/12 1976
date well completed

Jack Quinn
firm name

Warren
county well located

LANDOWNER: Thurman Nelson

description of formations encountered

from to

Red clay

1 20

GRAVEL

21 40

White Sand

41 60

Rock

61 140

Sand + clay

141 220

SAND

221 282

Vicksburg, Ms.
(mailing address)

WELL LOCATION:

sec. 3 T 15 N R 5 E
15 miles SE of Vicksburg
(distance) (direction) (nearest town)

WELL PURPOSE: HOME
(home, irrigation, municipal, industrial)

WELL COMPLETION DATA:

- (1) diameter (inches) 4"
- (2) total depth (feet) 282
- (3) static water level (feet) 30 below top of ground.
- (4) casing Iron, 240 (material) (depth)
4" (size) if telescope see back.
- (5) screen 15' 255' (length) (depth to top)
2" Stainless Steel (size) (material)
- (6) pump 1 (HP) 20 (yield gpm)
electricity (type power)
- (7) electric log Yes (yes or no)
Miss. Geological Survey (organization running log)
- (8) how well bottom plugged

CODED


RECEIVED
AUG 8 - 1976

DRILLERS REMARKS:

MISS. Bd. OF WATER COMM.

If well telescopes please sketch and show depths.

GROUND LEVEL

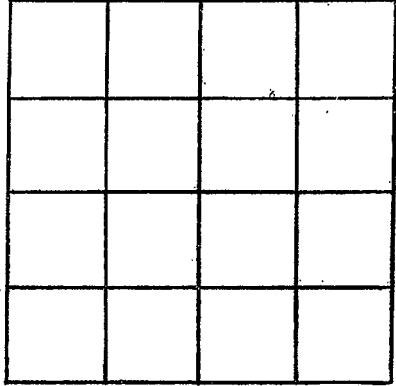

SECTION _____

Please indicate well location X.

ADDITIONAL INFORMATION

If more than one screen,
show locations of each on sketch.