

WARREN

05

4/14/81

4/14/81

date well completed

MISSISSIPPI BOARD OF WATER COMMISSIONERS

416 North State Street

Jackson, Mississippi 39201

CODED

WATER WELL DRILLERS LOG

Gunn Wellson WARREN

firm name

county well located

LANDOWNER:

RICK Selby
Bobby

(mailing address)

WELL LOCATION:

sec. 19 T 15 N R 5 E W
miles (distance) of (direction) of (nearest town)

WELL PURPOSE:

(home, irrigation, municipal, industrial)

WELL COMPLETION DATA:

- (1) diameter (inches) 4"
- (2) total depth (feet) 244
- (3) static water level (feet) 60 below top of ground.
- (4) casing PVC 2 1/4 (material), 49 (depth)
- (5) screen 30' 2 1/4 (length), 49 (depth to top)
- (6) pump 1 (HP), PVC 15 (material), 15 (yield gpm)

(type power)

(7) electric log (yes or no)

(organization running log)

(8) how well bottom plugged Real

description of formations encountered

from to

CLAY	0	100
SAND	120	130
ROCK CLAY	130	200
SANDY CLAY	200	214
SAND	214	244

CODED

DEPT. OF NATURAL RESOURCES
BUREAU OF LAND & WATER RESOURCES


FEB - 4 1982

RECEIVED

DRILLERS REMARKS:

If well telescopes please
sketch and show depths.

GROUND LEVEL

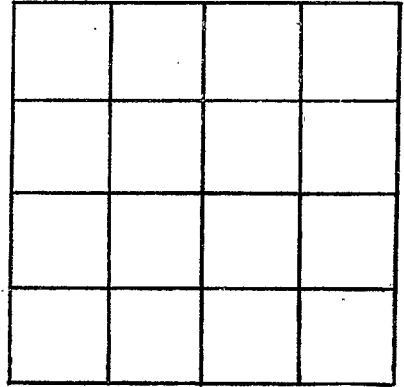

SECTION _____

Please indicate well location X.

ADDITIONAL INFORMATION

If more than one screen,
show locations of each on sketch.