

WARREN  
 07  
 3-31-75  
 Elec # 132  
 3-31

MISSISSIPPI  
 BOARD OF WATER COMMISSIONERS  
 416 North State Street  
 Jackson, Mississippi 39201

CODED

WATER WELL DRILLERS LOG

1975 JACK GUINN

WARREN

date well completed

firm name

county well located

LANDOWNER:

LEWIS

SANDERS

(mailing address)

WELL LOCATION:

sec. 29 T15 N R 5 E  
 S W

miles (distance) of (direction) (nearest town)

WELL PURPOSE:

(home, irrigation, municipal, industrial)

WELL COMPLETION DATA:

- (1) diameter (inches) 4"
- (2) total depth (feet) 264
- (3) static water level (feet) 10' below top of ground.
- (4) casing T&C 254' (material) (depth)  
 4" (size) if telescope see back.
- (5) screen 10' 8.54' (length) (depth to top)  
 2" (size) SS (material)
- (6) pump 3/4 (HP) 10 (yield gpm)  
 MDC (type power)
- (7) electric log YES (yes or no)  
 MGS (organization running log)
- (8) how well bottom plugged BCU.

description of formations encountered

from

to

TOP SOIL	0	10
SAND	10	58
ROCK	58	117
SAND	117	135
CLAY	135	267
SAND	267	267

CODED


RECEIVED  
 MAY - 3 1975

DRILLERS REMARKS:

OF WATER COMMISSIONERS

If well telescopes please sketch and show depths.

GROUND LEVEL

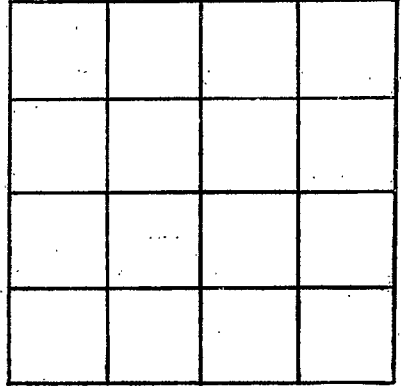

SECTION \_\_\_\_\_

Please indicate well location X.

ADDITIONAL INFORMATION

If more than one screen, show locations of each on sketch.