

WARREN
 09
 10-7-74
 E 60ft 130

MISSISSIPPI
 BOARD OF WATER COMMISSIONERS
 416 North State Street
 Jackson, Mississippi 39201

CODED

WATER WELL DRILLERS LOG

10-7-74 1974 JACK GUMM WARREN
 date well completed firm name county well located

LANDOWNER:
 Phoebe ERVES
 (mailing address)

WELL LOCATION:
 sec. 7 T. 15 N. R. 5 E
 (distance) miles (direction) of (nearest town)

WELL PURPOSE:
 (home, irrigation, municipal, industrial)

- WELL COMPLETION DATA:
- (1) diameter (inches) 4"
 - (2) total depth (feet) 230'
 - (3) static water level (feet) 28' below top of ground.
 - (4) casing T&C 220' (material) (depth)
 4" (size) if telescope see back.
 - (5) screen 10" 220' (length) (depth to top)
 2" (size) SS (material)
 - (6) pump 1 (HP) 10 (yield gpm)
 REC MPL (type power)
 - (7) electric log YES (yes or no)
 MGS (organization running log)
 - (8) how well bottom plugged B.W.V.

description of formations encountered	from	to
CLAY	0	25
SAND	25	30
CLAY	30	211
ROCK	211	210
CLAY	30	70
ROCK	70	78
CLAY	78	210
ROCK	210	211
SANDY SHALE	211	220
SAND	220	230

CODED


RECEIVED
 DEC 19 1974

DRILLERS REMARKS:

MISS. RD. OF WATER COMM

If well telescopes please sketch and show depths.

GROUND LEVEL

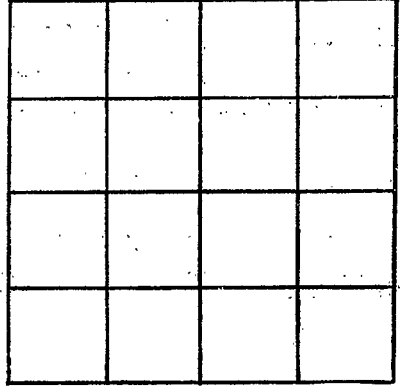

SECTION _____

Please indicate well location X.

ADDITIONAL INFORMATION

If more than one screen, show locations of each on sketch.