


If well telescopes please sketch and show depths.

GROUND LEVEL

352' - 4" casing
672' - 2" "

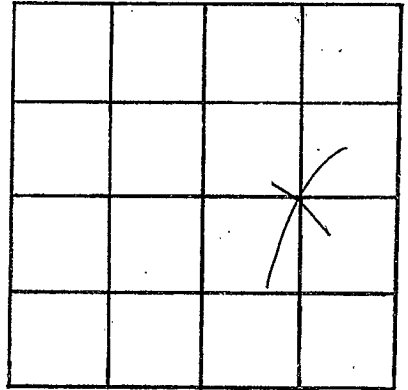

SECTION 1

Please indicate well location X.

ADDITIONAL INFORMATION

If more than one screen,
show locations of each on sketch.