

CODED

Warren
Q3
10-24-68

MISSISSIPPI
BOARD OF WATER COMMISSIONERS
416 North State Street
Jackson, Mississippi 39201

CODED

WATER WELL DRILLERS LOG

10/24 1968 BIG BLACK DRILLING Co. WARREN
date well completed firm name county well located

LANDOWNER: W. R. LOMINICK
2830 DRUMMOND ST.
VICKSBURG, MISS.
(mailing address)

description of formations encountered	from	to
SAND TOP SOIL	0	18
BLUE CHALK	18	50
SAND	50	78

WELL LOCATION:
? sec. 11 T. 14 N R. 2 E
13 miles S-S-W of VICKSBURG
(distance) (direction) (nearest town)

WELL PURPOSE: LIVESTOCK USE
(home, irrigation, municipal, industrial)

WELL COMPLETION DATA:
(1) diameter (inches) 2"
(2) total depth (feet) 78'
(3) static water level (feet) 8 below above top of ground.
(4) casing 2" GALV. 73'
(material) (depth)
(size) If telescope see back.
(5) screen 5" 73'
(length) (depth to top)
2" STAINLESS-STEEL
(size) (material)
(6) pump 16
(HP) (yield gpm)
GASOLINE
(type power)
(7) electric log NO
(yes or no)
(organization running log)

CODED

(8) how well bottom plugged BACK
WASH VALVE


DRILLERS REMARKS:
SET ON TOP OF
ROCK AT 78'

JAN - 6 1968

MISS. BD. OF
WATER COMM.

If well telescopes please sketch and show depths.

GROUND LEVEL

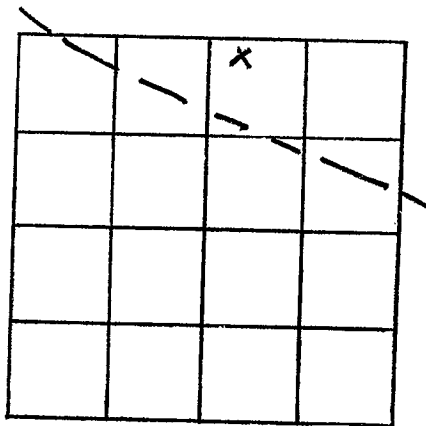

SECTION 11

Please indicate well location X.

ADDITIONAL INFORMATION

If more than one screen, show locations of each on sketch.