

Warren
 92000
 11-67

MISSISSIPPI
 BOARD OF WATER COMMISSIONERS
 416 North State Street
 Jackson, Mississippi 39201
 WATER WELL DRILLERS LOG

NOV. 15 1967 BIG BLACK DRILLING CO WARREN
 date well completed firm name county well located

LANDOWNER: DAN COLE

description of formations encountered

from to

BT 2, VICKSBURG, MISS.

<u>RED CLAY</u>	<u>0</u>	<u>30</u>
<u>WHITE CLAY</u>	<u>30</u>	<u>65</u>
<u>GRAVEL</u>	<u>65</u>	<u>67</u>
<u>BLUE SHELL WITH</u>		
<u>STREAKS OF ROCK</u>	<u>67</u>	<u>157</u>
<u>BLUE SAND</u>	<u>157</u>	<u>182</u>
<u>BLUE SHELL</u>	<u>182</u>	

(mailing address)

WELL LOCATION:

sec. 13 T. 13 S. R. 3 E. W.
10 miles SOUTH of VICKSBURG
 (distance) (direction) (nearest town)

WELL PURPOSE: HOME & FARM
 (home, irrigation, municipal, industrial)

WELL COMPLETION DATA:

- (1) diameter (inches) 2"
- (2) total depth (feet) 182'
- (3) static water level (feet) 62' ^{below} _{above} top of ground.
- (4) casing GAIV., 172'
 (material) (depth)
 _____ if telescope see back.
 (size)
- (5) screen 10', 172'
 (length) (depth to top)
2", STAINLESS STEEL
 (size) (material)
- (6) pump 1/2 ROD 4 1/2
 (HP) (yield gpm)


ELECTRICITY
 (type power)

(7) electric log NO
 (yes or no)

 (organization running log)


(8) how well bottom plugged BACK
WASH VALVE

DRILLERS REMARKS:

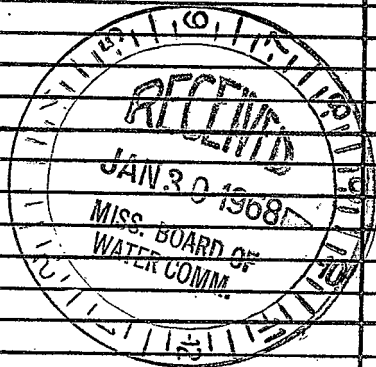

If well telescopes please sketch and show depths.

GROUND LEVEL

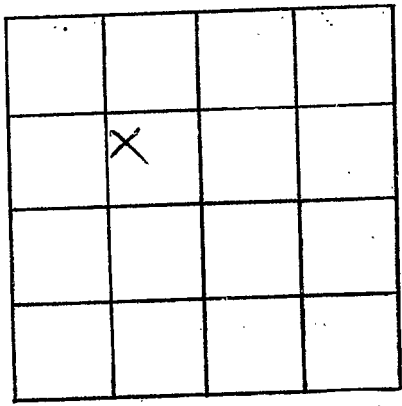

SECTION 13

Please indicate well location X.

ADDITIONAL INFORMATION

If more than one screen, show locations of each on sketch.